


| | | | | |
|----------------------------|-----------------------|----------------|-----------------|---|
| 1] LOCATION OF WATER WELL: | Fraction | Section Number | Township Number | Range Number |
| County: Geary | SW ¼ SW ¼ SW ¼ | 27 | T 11 S | R 6 EW |

Distance and direction from nearest town or city street address of well if located within city?

Marshall Army Airfield - Fort Riley, KS

2] WATER WELL OWNER: **Fort Riley, DES**
 RR#, St. Address, Box# : **1970 2nd St.** Board of Agriculture, Division of Water Resources
 City, State, ZIP Code : **Fort Riley, Kansas 66442-6016** Application Number:

3] LOCATE WELL'S LOCATION WITH AN "X" IN SECTION BOX:

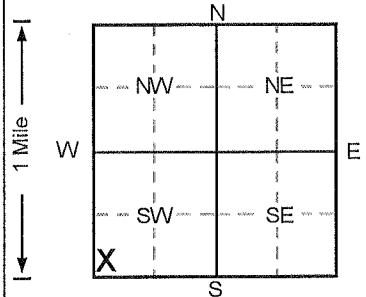

4] DEPTH OF COMPLETED WELL: **67** ft. ELEVATION: **1060**
 Depth(s) Groundwater Encountered 1. **21** ft. 2. _____ ft. 3. _____ ft.
 WELL'S STATIC WATER LEVEL: **23** ft. below land surface measured on mo/day/yr
 Pump test data: Well water was **NA** ft. after _____ hours pumping _____ gpm
 Est. Yield **NA** gpm; Well water was _____ ft. after _____ hours pumping _____ gpm
 Bore Hole Diameter **8** in. to **67.8** ft., and _____ in. to _____ ft.
 WELL WATER TO BE USED AS: 5 Public water supply 8 Air conditioning 11 Injection well
 1 Domestic 3 Feedlot 6 Oil field water supply 9 Dewatering 12 Other (Specify below)
 2 Irrigation 4 Industrial 7 Lawn and garden only 10 Monitoring well
 Was a chemical/bacteriological sample submitted to Department? Yes.....No ; If yes, mo/day/yr sample was submitted
 Water Well Disinfected? Yes _____ No

5] TYPE OF BLANK CASING USED: 5 Wrought iron 8 Concrete tile CASING JOINTS: Glued _____ Clamped _____
 1 Steel 3 RMP (SR) 6 Asbestos-Cement 9 Other (specify below) Welded _____
2 PVC 4 ABS 7 Fiberglass _____ Threaded
 Blank casing diameter **2** in. to **57** ft., Dia _____ in. to _____ ft., Dia _____ in. to _____ ft.
 Casing height above land surface **36** in., weight _____ lbs./ft. Wall thickness or gauge No. **Sch. 40**
 TYPE OF SCREEN OR PERFORATION MATERIAL: 7 PVC 10 Asbestos-cement
 1 Steel 3 Stainless steel 5 Fiberglass 8 RMP (SR) 11 Other (specify) _____
 2 Brass 4 Galvanized steel 6 Concrete tile 9 ABS 12 None used (open hole)
 SCREEN OR PERFORATION OPENINGS ARE: 5 Gauzed wrapped 8 Saw cut 11 None (open hole)
 1 Continuous slot 3 Mill slot 6 Wire wrapped 9 Drilled holes
 2 Louvered shutter 4 Key punched 7 Torch cut 10 Other (specify) _____
 SCREEN-PERFORATED INTERVALS: From **57** ft. to **67** ft., From _____ ft. to _____ ft.
 From _____ ft. to _____ ft., From _____ ft. to _____ ft.
 GRAVEL PACK INTERVALS: From **53** ft. to **67.6** ft., From _____ ft. to _____ ft.
 From _____ ft. to _____ ft., From _____ ft. to _____ ft.

6] GROUT MATERIAL: 1 Neat cement 2 Cement grout 3 Bentonite 4 Other _____
 Grout Intervals: From **0** ft. to **46** ft., From **46** ft. to **53** ft., From _____ ft. to _____ ft.
 What is the nearest source of possible contamination:
 1 Septic tank 4 Lateral lines 7 Pit privy 10 Livestock pens 14 Abandoned water well
 2 Sewer lines 5 Cess pool 8 Sewage lagoon 11 Fuel storage 15 Oil well/Gas well
 3 Watertight sewer lines 6 Seepage pit 9 Feedyard 12 Fertilizer storage 16 Other (specify below) **Fire Training Pit**
 3 Watertight sewer lines 6 Seepage pit 9 Feedyard 13 Insecticide storage
 Direction from well? **S** How many feet? **200**

| FROM | TO | LITHOLOGIC LOG | FROM | TO | PLUGGING INTERVALS |
|------|------|-------------------|------|----|--|
| 0 | 2 | Clay, Dark Gray | | | |
| 2 | 6 | Silt, Brown | | | |
| 6 | 7 | Clay, Dark Gray | | | |
| 7 | 10.5 | Sand, Pale Brown | | | |
| 10.5 | 11.5 | Silt, Brown | | | |
| 11.5 | 36 | Sand, Pale Brown | | | |
| 36 | 46 | Sand, Gray | | | |
| 46 | 49 | Clay, Dark Gray | | | |
| 49 | 54 | Sand, Gray Brown | | | |
| 54 | 55.5 | Sand, Gray Brown | | | |
| 55.5 | 60 | Sand, Gray Brown | | | |
| 60 | 65.8 | Sand, Brown | | | |
| 65.8 | 67.8 | Shale, Light Gray | | | |
| | | | | | FP-96-02c , Abovegrade |
| | | | | | Project Name: Louis Berger - Ft. Riley |
| | | | | | GeoCore # 358 , # |

7] CONTRACTOR'S OR LANDOWNER'S CERTIFICATION: This water well was 1 constructed, (2) reconstructed, or (3) plugged under my jurisdiction and was completed on (mo/day/year) **5/20/96** and this record is true to the best of my knowledge and belief.
 Kansas Water Well Contractor's License No. **527** This Water Well Record was completed on (mo/day/yr) **6/19/96**
 under the business name of **GeoCore Services, Inc.** by (signature) *Dan a Roll*