


1 LOCATION OF WATER WELL: County: Geary	Fraction SW ¼ SW ¼ SW ¼	Section Number 27	Township Number T 11 S	Range Number R 6 (E/W)
---	-----------------------------------	-----------------------------	----------------------------------	---

Distance and direction from nearest town or city street address of well if located within city?

Marshall Army Airfield - Fort Riley, KS

2 WATER WELL OWNER: **Fort Riley, DES**
 RR#, St. Address, Box # : **1970 2nd St.** Board of Agriculture, Division of Water Resources
 City, State, ZIP Code : **Fort Riley, Kansas 66442-6016** Application Number:

3 LOCATE WELL'S LOCATION WITH AN "X" IN SECTION BOX:

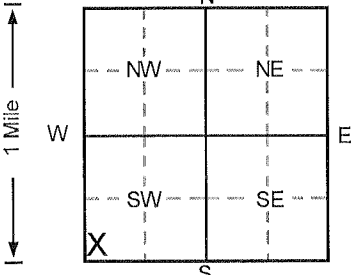

4 DEPTH OF COMPLETED WELL: **51.5** ft. ELEVATION: **999**

Depth(s) Groundwater Encountered 1. **21** ft. 2. _____ ft. 3. _____ ft.

WELL'S STATIC WATER LEVEL: **999** below land surface measured on mo/day/yr

Pump test data: Well water was **NA** ft. after _____ hours pumping _____ gpm

Est. Yield: **NA** gpm: Well water was _____ ft. after _____ hours pumping _____ gpm

Bore Hole Diameter: **8** in. to **51.5** ft., and _____ in. to _____ ft.

WELL WATER TO BE USED AS:

5 Public water supply	8 Air conditioning	11 Injection well
1 Domestic	3 Feedlot	6 Oil field water supply
2 Irrigation	4 Industrial	7 Lawn and garden only
		10 Monitoring well

Was a chemical/bacteriological sample submitted to Department? Yes _____ No ; If yes, mo/day/yr sample was submitted

Water Well Disinfected? Yes _____ No

5 TYPE OF BLANK CASING USED:

1 Steel	3 RMP (SR)	5 Wrought iron	8 Concrete tile	CASING JOINTS: Glued _____ Clamped _____
2 PVC	4 ABS	6 Asbestos-Cement	9 Other (specify below)	Welded _____
		7 Fiberglass		Threaded <input checked="" type="checkbox"/>

Blank casing diameter: **2** in. to **41** ft., Dia _____ in. to _____ ft., Dia _____ in. to _____ ft.

Casing height above land surface: **0** in., weight _____ lbs./ft. Wall thickness or gauge No. **Sch. 40**

TYPE OF SCREEN OR PERFORATION MATERIAL:

1 Steel	3 Stainless steel	5 Fiberglass	7 PVC	10 Asbestos-cement
2 Brass	4 Galvanized steel	6 Concrete tile	8 RMP (SR)	11 Other (specify) _____
			9 ABS	12 None used (open hole)

SCREEN OR PERFORATION OPENINGS ARE:

1 Continuous slot	3 Mill slot	5 Gauzed wrapped	8 Saw cut	11 None (open hole)
2 Louvered shutter	4 Key punched	6 Wire wrapped	9 Drilled holes	
		7 Torch cut	10 Other (specify) _____	

SCREEN-PERFORATED INTERVALS: From **41** ft. to **51.5** ft., From _____ ft. to _____ ft.

GRAVEL PACK INTERVALS: From **39** ft. to **51.5** ft., From _____ ft. to _____ ft.

6 GROUT MATERIAL: 1 Neat cement **2 Cement grout** **3 Bentonite** 4 Other _____

Grout Intervals: From **0** ft. to **25** ft., From **25** ft. to **39** ft., From _____ ft. to _____ ft.

What is the nearest source of possible contamination:

1 Septic tank	4 Lateral lines	7 Pit privy	10 Livestock pens	14 Abandoned water well
2 Sewer lines	5 Cess pool	8 Sewage lagoon	11 Fuel storage	15 Oil well/Gas well
3 Watertight sewer lines	6 Seepage pit	9 Feedyard	12 Fertilizer storage	16 Other (specify below)
			13 Insecticide storage	Fire Training Pit

Direction from well? **S** How many feet? **1000**

FROM	TO	LITHOLOGIC LOG	FROM	TO	PLUGGING INTERVALS
0	2	Silt, Dark Gray Brown	30	32	Sand, Dark Brown
2	4	Silt, Dark Gray Brown	32	34	Sand, Dark Brown
4	6	Silt, Dark Brown	34	36	Sand, Olive
6	8	Silt, Dark Brown	36	38	Sand, Very Dark Gray Brown
8	10	Silt, Dark Brown	38	40	Sand, Very Dark Gray Brown
10	12	Silt, Brown	40	42	Sand, Dark Olive Gray
12	14	Sand, Dark Brown	42	48	Sand, Dark Gray Brown
14	16	Sand, Pale Brown	48	51.5	Sand, Very Dark Gray Brown
16	18	Sand, Pale Brown			
18	20	Sand, Pale Brown			
20	22	Sand, Yellow Brown			
22	24	Sand, Yellow Brown			
24	26	Sand, Yellow Brown			FP-96-20b, Flushmount
26	28	Sand, Gray Brown			Project Name: Louis Berger - Ft. Riley
28	30	Sand, Yellow Brown			GeoCore # 358, #

7 CONTRACTOR'S OR LANDOWNER'S CERTIFICATION: This water well was **(1)** constructed, (2) reconstructed, or (3) plugged under my jurisdiction and was completed on (mo/day/year) **11/18/96** and this record is true to the best of my knowledge and belief.

Kansas Water Well Contractor's License No. **527** This Water Well Record was completed on (mo/day/yr) **12/9/96** under the business name of **GeoCore Services, Inc.** by (signature) *Don Riley*