


1 LOCATION OF WATER WELL: Fraction **SW 1/4 SW 1/4 SW 1/4** Section Number **27** Township Number **T 11 S** Range Number **R 6 E/W**
 County: **Geary**

Distance and direction from nearest town or city street address of well if located within city?
Marshall Army Airfield - Fort Riley, KS

2 WATER WELL OWNER: **Fort Riley, DES**
 RR#, St. Address, Box # : **1970 2nd St.** Board of Agriculture, Division of Water Resources
 City, State, ZIP Code : **Fort Riley, Kansas 66442-6016** Application Number:

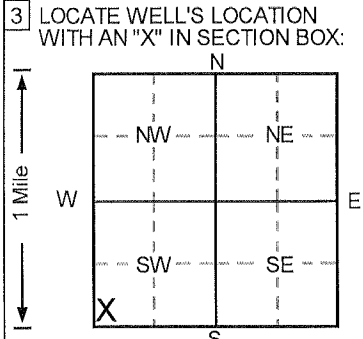

4 DEPTH OF COMPLETED WELL **47** ft. ELEVATION: **999**
 Depth(s) Groundwater Encountered 1. ft. 2. ft. 3. ft.
 WELL'S STATIC WATER LEVEL ... **999** ... ft. below land surface measured on mo/day/yr
 Pump test data: Well water was ... **NA** ... ft. after hours pumping gpm
 Est. Yield ... **NA** ... gpm: Well water was ft. after hours pumping gpm
 Bore Hole Diameter ... **8** ... in. to ... **47.1** ... ft., and in. to ft.
 WELL WATER TO BE USED AS: 5 Public water supply 8 Air conditioning 11 Injection well
 1 Domestic 3 Feedlot 6 Oil field water supply 9 Dewatering 12 Other (Specify below)
 2 Irrigation 4 Industrial 7 Lawn and garden only **10** Monitoring well
 Was a chemical/bacteriological sample submitted to Department? Yes.....No **✓**.....; If yes, mo/day/yr sample was submitted
 Water Well Disinfected? Yes No **✓**

5 TYPE OF BLANK CASING USED: 5 Wrought iron 8 Concrete tile CASING JOINTS: Glued Clamped
 1 Steel 3 RMP (SR) 6 Asbestos-Cement 9 Other (specify below) Welded
2 PVC 4 ABS 7 Fiberglass Threaded. **✓**
 Blank casing diameter **2** in. to ... **36.5** ft., Dia in. to ft., Dia in. to ft.
 Casing height above land surface **0** in., weight lbs./ft. Wall thickness or gauge No. ... **Sch. 40**
 TYPE OF SCREEN OR PERFORATION MATERIAL **7** PVC 10 Asbestos-cement
 1 Steel 3 Stainless steel 5 Fiberglass 8 RMP (SR) 11 Other (specify)
 2 Brass 4 Galvanized steel 6 Concrete tile 9 ABS 12 None used (open hole)
 SCREEN OR PERFORATION OPENINGS ARE: 5 Gauzed wrapped 8 Saw cut 11 None (open hole)
 1 Continuous slot **3** Mill slot 9 Wire wrapped 9 Drilled holes
 2 Louvered shutter 4 Key punched 7 Torch cut 10 Other (specify)
 SCREEN-PERFORATED INTERVALS: From **36.5** ft. to **47** ft., From ft. to ft.
 GRAVEL PACK INTERVALS: From **34.6** ft. to **47.1** ft., From ft. to ft.
 From ft. to ft., From ft. to ft.

6 GROUT MATERIAL: 1 Neat cement **2** Cement grout **3** Bentonite 4 Other
 Grout Intervals: From **0** ft. to ... **20** ft., From ... **20** ft. to ... **34.6** ft., From ft. to ft.
 What is the nearest source of possible contamination:
 1 Septic tank 4 Lateral lines 7 Pit privy 10 Livestock pens 14 Abandoned water well
 2 Sewer lines 5 Cess pool 8 Sewage lagoon 11 Fuel storage 15 Oil well/Gas well
 3 Watertight sewer lines 6 Seepage pit 9 Feedyard 12 Fertilizer storage **16** Other (specify below)
 Direction from well? **S** How many feet? **1000**
 ... **Fire Training Pit** ...

FROM	TO	LITHOLOGIC LOG	FROM	TO	PLUGGING INTERVALS
0	2	Silt, Brown	28	30	Sand, Yellow Brown
2	4	Silt, Light Brown	30	32	Sand, Gray
4	5	Silt, Light Brown	32	34	Sand, Brown
5	6	Silt, Brown	34	36	Sand, Light Olive Brown
6	8	Silt, Dark Brown	36	38	Sand, Light Olive Brown
8	10	Silt, Dark Brown	38	40	Sand, Light Olive Brown
10	12	Silt, Light Brown	40	42	Sand, Light Olive Brown
12	14	Silt, Light Brown	42	44	Sand, Light Olive Brown
14	15	Sand, Light Brown	44	47.1	Sand, Light Olive Brown
15	17	Sand, Light Orange Brown to Red Yellow Br			
17	20	Sand, Light Brown			
20	22	Sand, Light Orange Brown to Red Yellow			
22	24	Sand, Brown			FP-96-26b, Flushmount
24	26	Sand, Yellow Brown			Project Name: Louis Berger - Ft. Riley
26	28	Sand, Yellow Brown			GeoCore # 358, #

7 CONTRACTOR'S OR LANDOWNER'S CERTIFICATION: This water well was **1** constructed, (2) reconstructed, or (3) plugged under my jurisdiction and was completed on (mo/day/year) **11/18/96** and this record is true to the best of my knowledge and belief.
 Kansas Water Well Contractor's License No. **527** This Water Well Record was completed on (mo/day/yr) **12/9/96**
 under the business name of **GeoCore Services, Inc.** by (signature) *Dan Roll*