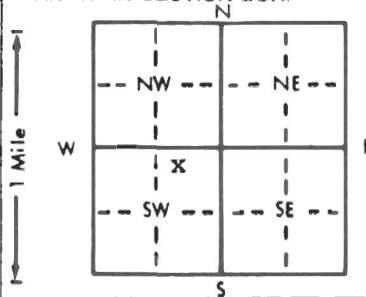


1 LOCATION OF WATER WELL: County: <u>Geary</u>	Fraction <u>NW 1/4 NE 1/4 SW 1/4</u>	Section Number <u>24</u>	Township Number <u>T 11 S</u>	Range Number <u>R 6 E</u>
---	---	-----------------------------	----------------------------------	------------------------------

Distance and direction from nearest town or city street address of well if located within city?
Approximately 5 1/2 miles east and 3 1/2 miles north of Junction City

2 WATER WELL OWNER: Morris County RWD #1
 RR#, St. Address, Box # : P.O. Box 146
 City, State, ZIP Code : Dwight, KS 66849
 Board of Agriculture, Division of Water Resources
 Application Number: 41,161

3 LOCATE WELL'S LOCATION WITH AN "X" IN SECTION BOX:


4 DEPTH OF COMPLETED WELL: 60 ft. ELEVATION: unknown
 Depth(s) Groundwater Encountered 1. ft. 2. ft. 3. ft.
 WELL'S STATIC WATER LEVEL 23 ft. below land surface measured on mo/day/yr 3-25-97
 Pump test data: Well water was Not ch'd ft. after hours pumping gpm
 Est. Yield unknown gpm: Well water was ft. after hours pumping gpm
 Bore Hole Diameter 30 in. to 59 ft., and in. to ft.
 WELL WATER TO BE USED AS:
 1 Domestic 3 Feedlot 6 Oil field water supply 9 Dewatering 12 Other (Specify below)
 2 Irrigation 4 Industrial 7 Lawn and garden only 10 Monitoring well
 Was a chemical/bacteriological sample submitted to Department? Yes No X; If yes, mo/day/yr sample was submitted
 Water Well Disinfected? Yes X No

5 TYPE OF BLANK CASING USED:
 1 Steel 3 RMP (SR) 5 Wrought iron 8 Concrete tile CASING JOINTS: Glued Clamped
 2 PVC 4 ABS 6 Asbestos-Cement 9 Other (specify below) Welded X
 7 Fiberglass Threaded
 Blank casing diameter 12 3/4 in. to 42 ft., Dia in. to ft., Dia in. to ft.
 Casing height above land surface 12 in., weight 49.56 lbs./ft. Wall thickness or gauge No. .375
 TYPE OF SCREEN OR PERFORATION MATERIAL:
 1 Steel 3 Stainless steel 5 Fiberglass 8 RMP (SR) 11 Other (specify)
 2 Brass 4 Galvanized steel 6 Concrete tile 9 ABS 12 None used (open hole)
 SCREEN OR PERFORATION OPENINGS ARE:
 1 Continuous slot 3 Mill slot 5 Gauzed wrapped 8 Saw cut 11 None (open hole)
 2 Louvered shutter 4 Key punched 6 Wire wrapped 9 Drilled holes
 7 Torch cut 10 Other (specify)
 SCREEN-PERFORATED INTERVALS: From 42 ft. to 59 ft., From ft. to ft.
 GRAVEL PACK INTERVALS: From 32 ft. to 59 ft., From ft. to ft.

6 GROUT MATERIAL: Dirt 1 Neat cement 2 Cement grout 3 Bentonite 4 Other 50% road sand and 50% Bentonite Holeplug
 Grout Intervals: From 0 ft. to 4 ft., From 4 ft. to 30 ft., From 30 ft. to 32 ft.
 What is the nearest source of possible contamination:
 1 Septic tank 4 Lateral lines 7 Pit privy 10 Livestock pens 14 Abandoned water well
 2 Sewer lines 5 Cess pool 8 Sewage lagoon 11 Fuel storage 15 Oil well/Gas well
 3 Watertight sewer lines 6 Seepage pit 9 Feedyard 12 Fertilizer storage 16 Other (specify below)
 13 Insecticide storage None known

Direction from well? How many feet?

FROM	TO	LITHOLOGIC LOG	FROM	TO	PLUGGING INTERVALS
0	3	Topsoil			
3	25	Clay, brown			
25	33	Clay, blue-green			
33	40	Chert gravel, 1/2", 1/2", 1", & 1 1/2"			
40	47	Chert gravel, dirty, 1/2", 1/2", & 1"			
47	58	Chert gravel, 1/2", 1/2", 1", & 1 1/2"			
58	59	Shale			

7 CONTRACTOR'S OR LANDOWNER'S CERTIFICATION: This water well was (1) constructed, (2) reconstructed, or (3) plugged under my jurisdiction and was completed on (mo/day/year) 3-25-97 and this record is true to the best of my knowledge and belief. Kansas Water Well Contractor's License No. 185 This Water Well Record was completed on (mo/day/yr) 3-28-97 under the business name of Clarke Well & Equipment, Inc. by (signature) Clarke Well & Equipment, Inc.

INSTRUCTIONS: Use typewriter or ball point pen. PLEASE PRESS FIRMLY and PRINT clearly. Please fill in blanks, underline or circle the correct answers. Send top three copies to Kansas Department of Health and Environment, Bureau of Water, Topeka, Kansas 66620-0001. Telephone: 913-296-5545. Send one to WATER WELL OWNER and retain one for your records.