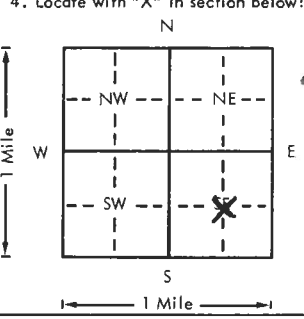
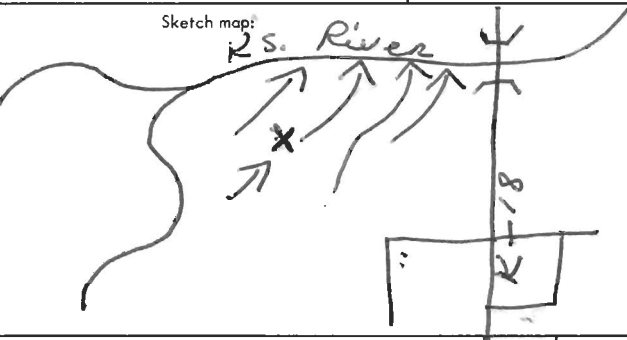


USE TYPEWRITER OR BALL POINT PEN-PRESS FIRMLY, PRINT CLEARLY.

WATER WELL RECORD
KSA 82a-1201-1215

Kansas Department of Health and Environment-Division of Environment
(Water well Contractors)
Topeka, Kansas 66620

1. Location of well:	County Geary	Fraction Center of XXXXXXX SE 1/4	Section number 22	Township number T 11S	Range number S R 6E E/W	
2. Distance and direction from nearest town or city: 3 mi. South of Ogden, Ks. on K-18 & 1 1/4 mi. west. Street address of well location if in city:			3. Owner of well: James Wahle R.R. or street: R. R. # 2-Box 80 City, state, zip code: Junction City, Kansas			
4. Locate with "X" in section below:  1 Mile			Sketch map: 			
5. Type and color of material			From	To	6. Bore hole dia. 30 in. Completion date 8-30-77 Well depth 52 ft.	
Black sandy soil			0	2	7. <input type="checkbox"/> Cable tool <input type="checkbox"/> Rotary <input type="checkbox"/> Driven <input type="checkbox"/> Dug <input type="checkbox"/> Hollow rod <input type="checkbox"/> Jetted <input type="checkbox"/> Bored <input checked="" type="checkbox"/> Reverse rotary	
Fine brown sand & med. gravel			2	11	8. Use: <input type="checkbox"/> Domestic <input type="checkbox"/> Public supply <input type="checkbox"/> Industry <input checked="" type="checkbox"/> Irrigation <input type="checkbox"/> Air conditioning <input type="checkbox"/> Stock <input type="checkbox"/> Lawn <input type="checkbox"/> Oil field water <input type="checkbox"/> Other	
Fine brown sand			11	18	9. Casing: Material Trans Height: Above or below Threaded <input type="checkbox"/> Welded <input type="checkbox"/> Surface 12" in. RMP <input type="checkbox"/> PVC <input type="checkbox"/> Weight <input type="checkbox"/> lbs./ft. Dia. 16 in. to 26 ft. depth Wall Thickness: inches or Dia. <input type="checkbox"/> in. to <input type="checkbox"/> ft. depth gage 75"	
Med. brown gravel & gray clay			18	21	10. Screen: Manufacturer's name Johnson Well Co. Type Transite Dia. 16" Slot/gauze 1/8 x 8 Length 26 Set between 26 ft. and 52 ft. <input type="checkbox"/> ft. and <input type="checkbox"/> ft. Gravel pack? yes Size range of material 1/8-1/4"	
Med. gray gravel			21	27	11. Static water level: <input type="checkbox"/> mo./day/yr. 17 ft. below land surface Date 6-26-77	
Med. gray gravel & gray clay			27	32	12. Pumping level below land surfaces: 21 ft. after 1 hrs. pumping 800 g.p.m. 30 ft. after 3 hrs. pumping 1000 g.p.m. Estimated maximum yield 1200 g.p.m.	
Med. gray gravel			32	34	13. Water sample submitted: <input type="checkbox"/> mo./day/yr. <input type="checkbox"/> Yes <input checked="" type="checkbox"/> No Date <input type="checkbox"/>	
Large gray gravel			34	52	14. Well head completion: <input type="checkbox"/> Pitless adapter <input type="checkbox"/> Inches above grade	
Stopped.			52		15. Well grouted? yes With: <input type="checkbox"/> Neat cement <input type="checkbox"/> Bentonite <input checked="" type="checkbox"/> Concrete Depth: From 0 ft. to 10 ft.	
					16. Nearest source of possible contamination: ft. 800 Direction east Type swale Well disinfected upon completion? <input type="checkbox"/> Yes <input checked="" type="checkbox"/> No	
					17. Pump: <input checked="" type="checkbox"/> Not installed Manufacturer's name <input type="checkbox"/> Model number <input type="checkbox"/> HP <input type="checkbox"/> Volts <input type="checkbox"/> Length of drop pipe <input type="checkbox"/> ft. capacity <input type="checkbox"/> g.p.m. Type: <input type="checkbox"/> Submersible <input type="checkbox"/> Turbine <input type="checkbox"/> Jet <input type="checkbox"/> Reciprocating <input type="checkbox"/> Centrifugal <input type="checkbox"/> Other	
(Use a second sheet if needed)						
18. Elevation: Topography: <input type="checkbox"/> Hill <input type="checkbox"/> Slope <input type="checkbox"/> Upland <input checked="" type="checkbox"/> Valley	19. Remarks: We do not install pumps. Delay in filing report due to wait in obtaining legal description.				20. Water well contractor's certification: This well was drilled under my jurisdiction and this report is true to the best of my knowledge and belief. Hoobler Drilling Co. 323 Business name License No. Address St. Marys, Ks. 66536 Signed Don Hoobler Date 9-26-77 Authorized representative	

T
R
M
Sec
1/4
1/4
1/4