


WATER WELL RECORD Form WWC-5 24 SA 82a-1212

1 LOCATION OF WATER WELL: County: Geary Fraction *See Below Section Number 28 Township Number T 11 S Range Number R 6 E/W

Distance and direction from nearest town or city street address of well if located within city?
TS0292-1 ±500' E of Henry Dr. & Marshall Ave., Main Post, Ft. Riley, Kansas

2 WATER WELL OWNER: U.S. Army Corps of Engineers
 RR#, St. Address, Box #: 601 East 12th Street Board of Agriculture, Division of Water Resources
 City, State, ZIP Code: Kansas City, Missouri 64106 Application Number:

3 LOCATE WELL'S LOCATION WITH AN "X" IN SECTION BOX:

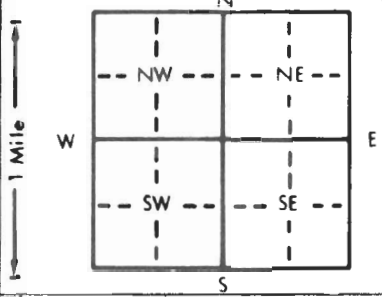

4 DEPTH OF COMPLETED WELL: 30.3 ft. ELEVATION: 1092.9
 Depth(s) Groundwater Encountered: 1. 24 ft. 2. _____ ft. 3. _____ ft.
 WELL'S STATIC WATER LEVEL: 25.0 ft. below land surface measured on mo/day/yr
 Pump test data: Well water was _____ ft. after _____ hours pumping _____ gpm
 Est. Yield _____ gpm: Well water was _____ ft. after _____ hours pumping _____ gpm
 Bore Hole Diameter: 11 in. to 33 in. and _____ in. to _____ in. ft.
 WELL WATER TO BE USED AS:
 1 Domestic 3 Feedlot 6 Oil field water supply 9 Dewatering 12 Other (Specify below)
 2 Irrigation 4 Industrial 7 Lawn and garden only Monitoring well
 Was a chemical/bacteriological sample submitted to Department? Yes _____ No If yes, mo/day/yr sample was submitted _____
 Water Well Disinfected? Yes _____ No

5 TYPE OF BLANK CASING USED:
 1 Steel 3 RMP (SR) 5 Wrought iron 8 Concrete tile CASING JOINTS: Glued _____ Clamped _____
 PVC 4 ABS 6 Asbestos-Cement 9 Other (specify below) Welded _____
 7 Fiberglass _____ Threaded
 Blank casing diameter: 2 in. to 33 in. Dia. _____ in. to _____ in. Dia. _____ in. to _____ in. ft.
 Casing height above land surface: 0 in., weight _____ lbs./ft. Wall thickness or gauge No. Sch 40

TYPE OF SCREEN OR PERFORATION MATERIAL:
 1 Steel 3 Stainless steel 5 Fiberglass PVC 10 Asbestos-cement
 2 Brass 4 Galvanized steel 6 Concrete tile 8 RMP (SR) 11 Other (specify) _____
 9 ABS 12 None used (open hole)

SCREEN OR PERFORATION OPENINGS ARE:
 1 Continuous slot Mill slot 5 Gauzed wrapped 8 Saw cut 11 None (open hole)
 2 Louvered shutter 4 Key punched 6 Wire wrapped 9 Drilled holes
 7 Torch cut 10 Other (specify) _____

SCREEN-PERFORATED INTERVALS: From 29.8 ft. to 19.8 ft. From _____ ft. to _____ ft.
 From _____ ft. to _____ ft. From _____ ft. to _____ ft.
 GRAVEL PACK INTERVALS: From 33 ft. to 16.8 ft. From _____ ft. to _____ ft.
 From _____ ft. to _____ ft. From _____ ft. to _____ ft.

6 GROUT MATERIAL: 1 Neat cement Cement grout 3 Bentonite 4 Other Bentonite Pellets 16.8'-14.5'
 Grout Intervals: From 14.5 ft. to 3.5 ft. From _____ ft. to _____ ft. From Concrete ft. From 3.5 ft. to 0 ft.

What is the nearest source of possible contamination:
 1 Septic tank 4 Lateral lines 7 Pit privy 10 Livestock pens 14 Abandoned water well
 2 Sewer lines 5 Cess pool 8 Sewage lagoon 11 Fuel storage 15 Oil well/Gas well
 3 Watertight sewer lines 6 Seepage pit 9 Feedyard 12 Fertilizer storage 16 Other (specify below)
 13 Insecticide storage UST Site _____

Direction from well? _____ How many feet? _____

FROM	TO	LITHOLOGIC LOG	FROM	TO	PLUGGING INTERVALS
0	1	Crushed Stone			
1	14.5	Brown Silt			
14.5	25.5	Brown Clay			
25.5	33	Lime Stone			
*Location referenced to Ft. Riley Datum					
267,708.5 N					
2,347,286.6 E					

7 CONTRACTOR'S OR LANDOWNER'S CERTIFICATION: This water well was constructed, (2) reconstructed, or (3) plugged under my jurisdiction and was completed on (mo/day/year) 12/22/92 and this record is true to the best of my knowledge and belief. Kansas Water Well Contractor's License No. 510 This Water Well Record was completed on (mo/day/yr) 3/24/93 under the business name of MIKON Corporation by (signature) David J. Kamer

INSTRUCTIONS: Use typewriter or ball point pen. PLEASE PRESS FIRMLY and PRINT clearly. Please fill in blanks, underline or circle the correct answers. Send top three copies to Kansas Department of Health and Environment, Bureau of Water, Topeka, Kansas 66620-0001. Telephone: 913-296-5545. Send one to WATER WELL OWNER and retain one for your records.