


1 LOCATION OF WATER WELL: County: Gary Fraction: NE 1/4 NE 1/4 SE 1/4 Section Number: 26 Township Number: T 11 S Range Number: R 6 E

Distance and direction from nearest town or city street address of well if located within city? From J.C. 60 6 miles East on I 70 to Exit 303 then 60 North 40th & Turn East 60 1/2 mile & 1/4 South

2 WATER WELL OWNER: Kevin Ascher RR#, St. Address, Box #: RR 2 Box 77 City, State, ZIP Code: Jie., Kansas 66441 Board of Agriculture, Division of Water Resources Application Number:

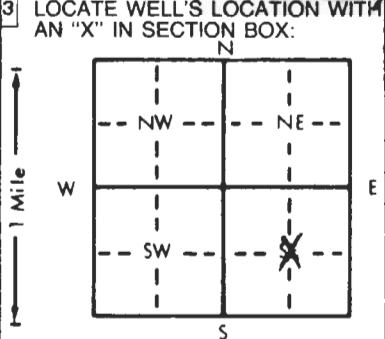

3 LOCATE WELL'S LOCATION WITH AN "X" IN SECTION BOX: DEPTH OF COMPLETED WELL: 80 ft. ELEVATION: ... ft.
 Depth(s) Groundwater Encountered 1. 46.58 ft. 2. ... ft. 3. ... ft.
 WELL'S STATIC WATER LEVEL 46.58 ft. below land surface measured on mo/day/yr
 Pump test data: Well water was ... ft. after ... hours pumping ... gpm
 Est. Yield 40 gpm Well water was ... ft. after ... hours pumping ... gpm
 Bore Hole Diameter 9 in. to 80 ft., and ... in. to ... ft.
 WELL WATER TO BE USED AS:
 1 Domestic 3 Feedlot 6 Oil field water supply 9 Dewatering 12 Other (Specify below)
 2 Irrigation 4 Industrial 7 Lawn and garden only 10 Monitoring well
 Was a chemical/bacteriological sample submitted to Department? Yes ... No ... If yes, mo/day/yr sample was submitted
 Water Well Disinfected? Yes No

5 TYPE OF BLANK CASING USED:
 1 Steel 3 RMP (SR) 5 Wrought iron 8 Concrete tile CASING JOINTS: Gasketed Clamped
 2 PVC 4 ABS 6 Asbestos-Cement 9 Other (specify below) Welded Stacked
 7 Fiberglass Threaded
 Blank casing diameter 5 in. to 60 ft., Dia. ... in. to ... ft., Dia. ... in. to ... ft.
 Casing height above land surface 2' in., weight 160 lbs./ft. Wall thickness or gauge No. ...
 TYPE OF SCREEN OR PERFORATION MATERIAL:
 1 Steel 3 Stainless steel 5 Fiberglass 7 PVC 10 Asbestos-cement
 2 Brass 4 Galvanized steel 6 Concrete tile 9 ABS 12 None used (open hole)
 SCREEN OR PERFORATION OPENINGS ARE:
 1 Continuous slot 3 Mill slot 3/1600's 5 Gauzed wrapped 8 Saw cut 11 None (open hole)
 2 Louvered shutter 4 Key punched 6 Wire wrapped 9 Drilled holes
 7 Torch cut 10 Other (specify) ...
 SCREEN-PERFORATED INTERVALS: From ... ft. to 80 ft., From ... ft. to ... ft.
 GRAVEL PACK INTERVALS: From 20 ft. to 80 ft., From ... ft. to ... ft.

6 GROUT MATERIAL: 1 Neat cement 2 Cement grout 3 Bentonite 4 Other
 Grout intervals: From 0 ft. to 20 ft., From ... ft. to ... ft. to ENVIRONMENT ft. From ... ft. to ... ft.
 What is the nearest source of possible contamination:
 1 Septic tank 4 Lateral lines 7 Pit privy 10 Livestock pens 14 Abandoned water well
 2 Sewer lines 5 Cess pool 8 Sewage lagoon 11 Fuel storage 15 Oil well/Gas well
 3 Watertight sewer lines 6 Seepage pit 9 Feedyard 12 Fertilizer storage 16 Other (specify below)
 13 Insecticide storage
 Direction from well? EAST How many feet? 100'

FROM	TO	LITHOLOGIC LOG	FROM	TO	PLUGGING INTERVALS
0	8	BROWN CLAY	58	70	LIMESTONE (WATER)
8	14	BROWN CLAY & GRAVEL	70	75	GREY SHALE
14	15	LIMESTONE	75	78	LIMESTONE
15	17	Yellow Shale	78	80	GREY SHALE
17	22	Greenish Shale			
22	29	Brown Shale			
29	32	LIMESTONE			
32	37	Grey Shale			
37	41	Green Shale			
41	43	Limestone			
43	47	Brown Shale			
47	50	LIMESTONE			
50	55	Grey Shale			
55	56	LIMESTONE			
56	58	Grey Shale			

7 CONTRACTOR'S OR LANDOWNER'S CERTIFICATION: This water well was (1) constructed, (2) reconstructed, or (3) plugged under my jurisdiction and was completed on (mo/day/year) 2/27/91 and this record is true to the best of my knowledge and belief. Kansas Water Well Contractor's License No. 451 This Water Well Record was completed on (mo/day/yr) 2/27/91 under the business name of Halderton Well Drilling by (signature) Craig Halderton