


1 LOCATION OF WATER WELL: Fraction * See Below Section Number Township Number Range Number
 County: Geary SW 1/4 SW 1/4 NE 1/4 33 T 11 S R 6 EW

Distance and direction from nearest town or city street address of well if located within city?

Camp Forsyth, Ft. Riley, Kansas

2 WATER WELL OWNER: U.S. Army Corps of Engineers TS0893-1
 RR#, St. Address, Box #: 601 East 12th Street Board of Agriculture, Division of Water Resource
 City, State, ZIP Code: Kansas City, Missouri 64106 Application Number:

3 LOCATE WELL'S LOCATION WITH AN "X" IN SECTION BOX: 4 DEPTH OF COMPLETED WELL: 22.0 ft. ELEVATION: 1067.1

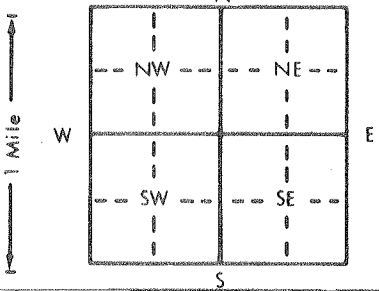

Depth(s) Groundwater Encountered 1. 12 ft. 2. ft. 3. ft.
 WELL'S STATIC WATER LEVEL ft. below land surface measured on mo/day/yr
 Pump test data: Well water was ft. after hours pumping gpm
 Est. Yield gpm: Well water was ft. after hours pumping gpm
 Bore Hole Diameter: 11 in. to 22.5 ft., and in. to ft.
 WELL WATER TO BE USED AS: 5 Public water supply 8 Air conditioning 11 Injection well
 1 Domestic 3 Feedlot 6 Oil field water supply 9 Dewatering 12 Other (Specify below)
 2 Irrigation 4 Industrial 7 Lawn and garden only 10 Monitoring well
 Was a chemical/bacteriological sample submitted to Department? Yes No X; If yes, mo/day/yr sample was submitted
 Water Well Disinfected? Yes No X

5 TYPE OF BLANK CASING USED: 5 Wrought iron 8 Concrete tile CASING JOINTS: Glued Clamped
 1 Steel 3 RMP (SR) 6 Asbestos-Cement 9 Other (specify below) Welded
 2 PVC 4 ABS 7 Fiberglass Threaded X

Blank casing diameter 2 in. to 12 ft., Dia in. to ft., Dia in. to ft.
 Casing height above land surface 0 in., weight flush mount cover lbs./ft. Wall thickness or gauge No. Sch. 40

TYPE OF SCREEN OR PERFORATION MATERIAL: 7 PVC 10 Asbestos-cement
 1 Steel 3 Stainless steel 5 Fiberglass 8 RMP (SR) 11 Other (specify)
 2 Brass 4 Galvanized steel 6 Concrete tile 9 ABS 12 None used (open hole)

SCREEN OR PERFORATION OPENINGS ARE: 5 Gauzed wrapped 8 Saw cut 11 None (open hole)
 1 Continuous slot 3 Mill slot 6 Wire wrapped 9 Drilled holes
 2 Louvered shutter 4 Key punched 7 Torch cut 10 Other (specify)

SCREEN-PERFORATED INTERVALS: From 22 ft. to 12 ft., From ft. to ft.
 GRAVEL PACK INTERVALS: From 22.5 ft. to 10 ft., From ft. to ft.

6 GROUT MATERIAL: 1 Neat cement 2 Cement grout 3 Bentonite 4 Other Bentonite Pellets 10'-7.5'
 Grout Intervals: From 7.5 ft. to 3.5 ft., From Concrete ft., From 3.5 ft. to 0 ft.

What is the nearest source of possible contamination:
 1 Septic tank 4 Lateral lines 7 Pit privy 10 Livestock pens 14 Abandoned water well
 2 Sewer lines 5 Cess pool 8 Sewage lagoon 11 Fuel storage 15 Oil well/Gas well
 3 Watertight sewer lines 6 Seepage pit 9 Feedyard 12 Fertilizer storage 16 Other (specify below)
 13 Insecticide storage UST Site

Direction from well? East How many feet? ±30

FROM	TO	LITHOLOGIC LOG	FROM	TO	PLUGGING INTERVALS
0	7"	Concrete			
7"	5.5'	Brown Silty Sand			
5.5'	6.5'	Brown Silty Clay			
6.5'	9.5'	Brown Silty Sand			
9.5'	22.5'	Brown to Gray, Fine to Coarse Sand			
		* Location referenced to Ft. Riley Datum			
		267, 109.6 N			
		2, 334, 139.1 E			

7 CONTRACTOR'S OR LANDOWNER'S CERTIFICATION: This water well was 1 constructed, (2) reconstructed, or (3) plugged under my jurisdiction and was completed on (mo/day/year) 10/19/93 and this record is true to the best of my knowledge and belief. Kansas Water Well Contractor's License No. 510 This Water Well Record was completed on (mo/day/yr) 12/14/93 under the business name of MIKON Corporation by (signature) David S. Kramer