


1 LOCATION OF WATER WELL: Fraction \* See Below Section Number Township Number Range Number  
 County: Geary SE 1/4 SW 1/4 NE 1/4 33 T 11 S R 6 EW

Distance and direction from nearest town or city street address of well if located within city?

2 WATER WELL OWNER: U.S. Army Corps of Engineers TS1593-1  
 RR#, St. Address, Box # : 601 East 12th Street Board of Agriculture, Division of Water Resource  
 City, State, ZIP Code : Kansas City, Missouri 64106 Application Number:

3 LOCATE WELL'S LOCATION WITH AN "X" IN SECTION BOX:

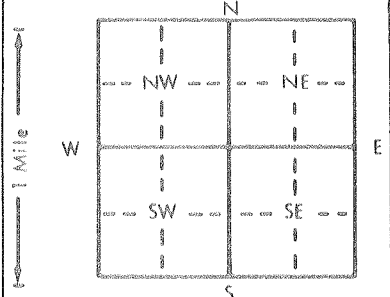

4 DEPTH OF COMPLETED WELL: 48.5 ft. ELEVATION: 1134.0  
 Depth(s) Groundwater Encountered 1. 36.0 ft. 2. ft. 3. ft.  
 WELL'S STATIC WATER LEVEL: ft. below land surface measured on mo/day/yr  
 Pump test data: Well water was ft. after hours pumping gpm  
 Est. Yield gpm: Well water was ft. after hours pumping gpm  
 Bore Hole Diameter: 11 in. to 49.0 ft., and in. to ft.  
 WELL WATER TO BE USED AS:  
 1 Domestic 3 Feedlot 6 Oil field water supply 9 Dewatering 12 Other (Specify below)  
 2 Irrigation 4 Industrial 7 Lawn and garden only 10 Monitoring well  
 Was a chemical/bacteriological sample submitted to Department? Yes No X; If yes, mo/day/yr sample was submitted Water Well Disinfected? Yes No X

5 TYPE OF BLANK CASING USED:  
 1 Steel 3 RMP (SR) 5 Wrought iron 8 Concrete tile CASING JOINTS: Glued Clamped  
 2 PVC 4 ABS 6 Asbestos-Cement 9 Other (specify below) Welded  
 7 Fiberglass Threaded X  
 Blank casing diameter: 2 in. to 38.5 ft., Dia. in. to ft., Dia. in. to ft.  
 Casing height above land surface: 0 in., weight Flush mount cover lbs./ft. Wall thickness or gauge No. Sch 40

TYPE OF SCREEN OR PERFORATION MATERIAL:  
 1 Steel 3 Stainless steel 5 Fiberglass 7 PVC 10 Asbestos-cement  
 2 Brass 4 Galvanized steel 6 Concrete tile 8 RMP (SR) 11 Other (specify)  
 9 ABS 12 None used (open hole)

SCREEN OR PERFORATION OPENINGS ARE:  
 1 Continuous slot 3 Mill slot 5 Gauzed wrapped 8 Saw cut 11 None (open hole)  
 2 Louvered shutter 4 Key punched 6 Wire wrapped 9 Drilled holes  
 7 Torch cut 10 Other (specify)

SCREEN-PERFORATED INTERVALS: From 48.5 ft. to 38.5 ft., From ft. to ft.  
 From ft. to ft., From ft. to ft.  
 GRAVEL PACK INTERVALS: From 49 ft. to 35.5 ft., From ft. to ft.  
 From ft. to ft., From ft. to ft.

6 GROUT MATERIAL: 1 Neat cement 2 Cement grout 3 Bentonite 4 Other Bentonite Pellets 35.5'-31'...  
 Grout Intervals: From 31.0 ft. to 3.5 ft., From ft. to Concrete ft., From 3.5 ft. to 0 ft.

What is the nearest source of possible contamination:  
 1 Septic tank 4 Lateral lines 7 Pit privy 10 Livestock pens 14 Abandoned water well  
 2 Sewer lines 5 Cess pool 8 Sewage lagoon 11 Fuel storage 15 Oil well/Gas well  
 3 Watertight sewer lines 6 Seepage pit 9 Feedyard 12 Fertilizer storage 16 Other (specify below)  
 13 Insecticide storage  
 Direction from well? North East How many feet? ±30

FROM	TO	LITHOLOGIC LOG	FROM	TO	PLUGGING INTERVALS
0"	7"	Concrete			
7"	6.5'	Brown Clay			
6.5'	7.5'	Brown Sandy Silt			
7.5'	10'	Brown Sand Fine to Coarse			
10'	17'	Brown Silty Clay			
17'	31.5'	Brown Sand, Fine to Coarse			
31.5'	44'	Limestone w/Clay and Shale Seams			
44'	49'	Shale			

7 CONTRACTOR'S OR LANDOWNER'S CERTIFICATION: This water well was 1 constructed, (2) reconstructed, or (3) plugged under my jurisdiction and was completed on (mo/day/year) 10/13/93 and this record is true to the best of my knowledge and belief. Kansas Water Well Contractor's License No. 510 This Water Well Record was completed on (mo/day/yr) 12/14/93 under the business name of MIKON Corporation by (signature) David J. Kram