


1 LOCATION OF WATER WELL: County: <b>Geary</b>	Fraction <b>SW ¼ SW ¼ SW ¼</b>	Section Number <b>27</b>	Township Number <b>T 11 S</b>	Range Number <b>R 6 E/W</b>
---	-----------------------------------	-----------------------------	----------------------------------	--------------------------------

Distance and direction from nearest town or city street address of well if located within city?  
**Marshall Army Airfield - Fort Riley, KS**

2 WATER WELL OWNER: **Fort Riley, DES**  
 RR#, St. Address, Box # : **1970 2nd St.** Board of Agriculture, Division of Water Resources  
 City, State, ZIP Code : **Fort Riley, Kansas 66442-6016** Application Number:

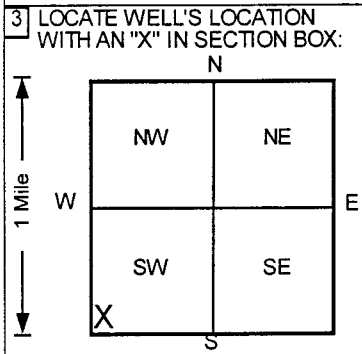

4 DEPTH OF COMPLETED WELL ..... **16** ..... ft. ELEVATION: ..... **999** .....  
 Depth(s) Groundwater Encountered 1. .... **10** ..... ft. 2. .... ft. 3. .... ft.  
 WELL'S STATIC WATER LEVEL ..... **999** ..... ft. below land surface measured on mo/day/yr  
 Pump test data: Well water was ..... **NA** ..... ft. after ..... hours pumping ..... gpm  
 Est. Yield .. **NA** .. gpm: Well water was ..... ft. after ..... hours pumping ..... gpm  
 Bore Hole Diameter ..... **8** ..... in. to ..... **5** ..... ft., and ..... in. to ..... ft.  
 WELL WATER TO BE USED AS: 5 Public water supply 8 Air conditioning 11 Injection well  
 1 Domestic 3 Feedlot 6 Oil field water supply 9 Dewatering 12 Other (Specify below)  
 2 Irrigation 4 Industrial 7 Lawn and garden only **10** Monitoring well  
 Was a chemical/bacteriological sample submitted to Department? Yes.....No.....; If yes, mo/day/yr sample was submitted  
 Water Well Disinfected? Yes No

5 TYPE OF BLANK CASING USED: 5 Wrought iron 8 Concrete tile CASING JOINTS: Glued ..... Clamped .....  
 1 Steel 3 RMP (SR) 6 Asbestos-Cement 9 Other (specify below) Welded .....  
 2 PVC 4 ABS 7 Fiberglass Threaded.   
 Blank casing diameter ..... **2** ..... in. to ..... **6** ..... ft., Dia ..... in. to ..... ft., Dia ..... in. to ..... ft.  
 Casing height above land surface ..... **0** ..... in., weight ..... lbs./ft. Wall thickness or gauge No. .... **Sch. 40** ....  
 TYPE OF SCREEN OR PERFORATION MATERIAL 7 PVC 10 Asbestos-cement  
 1 Steel  3 Stainless steel 5 Fiberglass 8 RMP (SR) 11 Other (specify) .....  
 2 Brass  4 Galvanized steel 6 Concrete tile 9 ABS 12 None used (open hole)  
 SCREEN OR PERFORATION OPENINGS ARE: 5 Gauzed wrapped 8 Saw cut 11 None (open hole)  
 1 Continuous slot  3 Mill slot 6 Wire wrapped 9 Drilled holes  
 2 Louvered shutter 4 Key punched 7 Torch cut 10 Other (specify) .....  
 SCREEN-PERFORATED INTERVALS: From ..... **6** ..... ft. to ..... **16** ..... ft., From ..... ft. to ..... ft.  
 From ..... ft. to ..... ft., From ..... ft. to ..... ft.  
 GRAVEL PACK INTERVALS: From ..... **5** ..... ft. to ..... **16** ..... ft., From ..... ft. to ..... ft.  
 From ..... ft. to ..... ft., From ..... ft. to ..... ft.

6 GROUT MATERIAL: 1 Neat cement  2 Cement grout  3 Bentonite 4 Other .....  
 Grout Intervals: From ..... **0** ..... ft. to .. **3(Cem)** ..... ft., From ..... **3** ..... ft. to .. **5(Ben)** ..... ft., From ..... ft. to ..... ft.  
 What is the nearest source of possible contamination:  
 1 Septic tank  4 Lateral lines  7 Pit privy  10 Livestock pens  14 Abandoned water well  
 2 Sewer lines  5 Cess pool  8 Sewage lagoon  11 Fuel storage  15 Oil well/Gas well  
 3 Watertight sewer lines  6 Seepage pit  9 Feedyard  12 Fertilizer storage  16 Other (specify below)  
 Direction from well? **S** How many feet? **700**  
**Fire Training Pit**

FROM	TO	LITHOLOGIC LOG	FROM	TO	PLUGGING INTERVALS
0	2	Silt, Dark Gray Brown			
2	4	Sand, Yellow			Augered to 5'
4	6	Silt, Black			Well Point driven to 16'
6	8	Sandy Silt, Black to Yellow			
8	10	Sandy Silt, Yellow			
10	12	Sand, Dark Gray			
12	14	Sand, Very Dark Gray Brown			
14	16	Sand, Green Gray			Revised Copy
					FP-96-25, Flushmount
					Project Name: Louis Berger - Ft. Riley
					GeoCore # 358, #

7 CONTRACTOR'S OR LANDOWNER'S CERTIFICATION: This water well was  (1) constructed, (2) reconstructed, or (3) plugged under my jurisdiction and was completed on (mo/day/year) ..... **11/18/96** ..... and this record is true to the best of my knowledge and belief.  
 Kansas Water Well Contractor's License No. .... **527** ..... This Water Well Record was completed on (mo/day/yr) ..... **12/9/96** .....  
 under the business name of **GeoCore Services, Inc.** by (signature) *[Signature]*