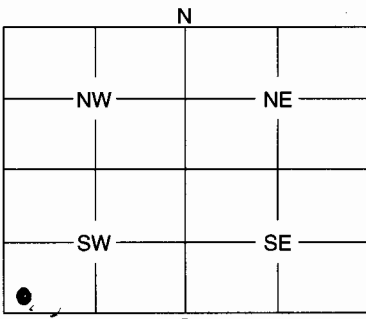


1 LOCATION OF WATER WELL:	Fraction	Section Number	Township Number	Range Number																								
County: <u>Geary</u>	<u>SW 1/4 SW 1/4 SW 1/4</u>	<u>28</u>	<u>11 S</u>	<u>6</u> <u>EA</u>																								
Distance and direction from nearest town or city street address of well if located within city? <u>NA</u>																												
2 WATER WELL OWNER: <u>US Army Directorate of Environment & Safety</u>																												
RR #, St. Address, Box #: City, State, ZIP Code :		Board of Agriculture, Division of Water Resources Application Number:																										
<u>407 Pershing Court</u> <u>Ex Riley, KS 66442</u>																												
3 MARK WELL'S LOCATION WITH AN "X" IN SECTION BOX:	4 DEPTH OF WELL <u>30.5</u> ft.																											
	WELL'S STATIC WATER LEVEL <u>24.8</u> ft.																											
	WELL WAS USED AS:																											
	<table style="width:100%;"><tr><td>1 Domestic</td><td>5 Public Water Supply</td><td>9 Dewatering</td></tr><tr><td>2 Irrigation</td><td>6 Oil Field Water Supply</td><td><u>10</u> Monitoring Well</td></tr><tr><td>3 Feedlot</td><td>7 Domestic (Lawn & Garden)</td><td>11 Injection Well</td></tr><tr><td>4 Industrial</td><td>8 Air Conditioning</td><td>12 Other</td></tr>
 Was a chemical / bacteriological sample submitted to Department? Yes No ☒ <u>NA</u> Casing height above or below land surface <u>DATA NOT CALCULATED</u> Water Well Disinfected: Yes No ☒																												
5 TYPE OF BLANK CASING USED:																												
<table style="width:100%;"><tr><td>1 <u>Steel</u></td><td>3 RMP (SR)</td><td>5 Wrought</td><td>7 Fiberglass</td><td>9 Other (Specify below)</td></tr><tr><td><u>2 PVC</u></td><td>4 ABS</td><td>6 Asbestos-Cement</td><td>8 Concrete Tile</td><td></td></tr></table> Blank casing diameter <u>3/4</u> in. Was casing pulled? Yes No ☒ If yes, how much					1 <u>Steel</u>	3 RMP (SR)	5 Wrought	7 Fiberglass	9 Other (Specify below)	<u>2 PVC</u>	4 ABS	6 Asbestos-Cement	8 Concrete Tile															
6 GROUT PLUG MATERIAL: <u>1 Neat cement</u> 2 Cement grout 3 Bentonite 4 Other																												
Grout Plug Intervals: From ft. to ft., From ft. to ft., From to ft.																												
What is the nearest source of possible contamination:																												
<table style="width:100%;"><tr><td>1 Septic tank</td><td>6 Seepage pit</td><td>11 Fuel storage</td><td>16 Other (specify below)</td></tr><tr><td>2 Sewer lines</td><td>7 Pit privy</td><td>12 Fertilizer storage</td><td></td></tr><tr><td>3 Watertight sewer lines</td><td>8 Sewage lagoon</td><td>13 Insecticide storage</td><td></td></tr><tr><td>4 Lateral lines</td><td>9 Feedyard</td><td>14 Abandoned water well</td><td></td></tr><tr><td>5 Cess pool</td><td>10 Livestock pens</td><td>15 Oil well/Gas well</td><td></td></tr>
Direction from well? How many feet?																												
<table border="1" style="width:100%; border-collapse: collapse;"><thead><tr><th style="width:10%;">FROM</th><th style="width:10%;">TO</th><th style="width:80%;">PLUGGING MATERIALS</th></tr></thead><tbody><tr><td><u>0</u></td><td><u>3</u></td><td><u>Fill Dirt</u></td></tr><tr><td><u>3</u></td><td><u>30.5</u></td><td><u>Neat Cement</u></td></tr><tr><td> </td><td> </td><td> </td></tr><tr><td> </td><td> </td><td> </td></tr><tr><td> </td><td> </td><td> </td></tr><tr><td> </td><td> </td><td> </td></tr><tr><td> </td><td> </td><td> </td></tr>
7 CONTRACTOR'S OF LANDOWNER'S CERTIFICATION: This water well was plugged under my jurisdiction and was completed on (mo/day/year) <u>08/17/04</u> and this record is true to the best of my knowledge and belief. Kansas Water Well Contractor's License No. <u>NA</u> This Water Well Record was completed on (mo/day/year) <u>09/30/04</u> under the business name of <u>USACE-NWR-EC-GG</u> by (signature) <u>[Signature]</u>																												

INSTRUCTIONS: Use typewriter or ball point pen. Please press firmly and print clearly. Please fill in blanks, underline or circle the correct answers. Send top three copies to Kansas Department of Health and Environment, Bureau of Water, Geology Section, 1000 SW Jackson St., Ste. 420, Topeka, Kansas 66612-1367. Telephone: 785/296-5522. Send one to Water Well Owner and retain one for your records.