

CORRECTION(S) TO WATER WELL RECORD (WWC-5)

(to rectify lacking or incorrect information)

Location listed as:

Section-Township-Range: None Given

Fraction ($\frac{1}{4}$ $\frac{1}{4}$ $\frac{1}{4}$): _____

County: Geary

Location changed to:

33-115-6E

NE NW NE

Other changes: Initial statements: Riley County

Changed to: Geary County

Comments: _____

verification method: Lat./Long. values, and Junction City


1:24,000 topo. map.

initials: DRL date: 7/21/2005

1 LOCATION OF WATER WELL: County: Riley Fraction $\frac{1}{4}$ $\frac{1}{4}$ $\frac{1}{4}$ Section Number Township Number Range Number
 T S R E/W

Distance and direction from nearest town or city street address of well if located within city? N40 83
On Ft. Riley Military Reservation Lat-39° 3' 26.99" Long-96° 46' 11.48"

2 WATER WELL OWNER: FORT RILEY WELL# 354-00-P220
 RR#, St. Address, Box #: Directorate of Environment & Safety Board of Agriculture, Division of Water Resources
 City, State, ZIP Code: Bldg 470 Pershing Ct, Ft Riley, KS 66449 Application Number:

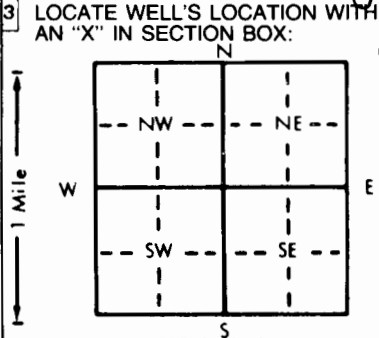

4 DEPTH OF COMPLETED WELL: 22.6 ft. ELEVATION:
 Depth(s) Groundwater Encountered 1. 16.6' ft. 2. from top of riser ft. 3. below land surface ft.
 WELL'S STATIC WATER LEVEL 16.6' ft. measured on mo/day/yr 4/26/05
 Pump test data: Well water was _____ ft. after _____ hours pumping _____ gpm
 Est. Yield _____ gpm: Well water was _____ ft. after _____ hours pumping _____ gpm
 Bore Hole Diameter _____ in. to _____ ft., and _____ in. to _____ ft.
 WELL WATER TO BE USED AS:
 5 Public water supply 8 Air conditioning 11 Injection well
 1 Domestic 3 Feedlot 6 Oil field water supply 9 Dewatering 12 Other (Specify below)
 2 Irrigation 4 Industrial 7 Lawn and garden only 10 Monitoring well
 Was a chemical/bacteriological sample submitted to Department? Yes _____ No _____; If yes, mo/day/yr sample was submitted _____
 Water Well Disinfected? Yes _____ No _____

5 TYPE OF BLANK CASING USED:
 Steel 3 RMP (SR) 5 Wrought iron 8 Concrete tile CASING JOINTS: Glued _____ Clamped _____
 PVC 4 ABS 6 Asbestos-Cement 9 Other (specify below) Welded _____
 7 Fiberglass Threaded _____
 Blank casing diameter 3.14 in. to _____ ft., Dia _____ in. to _____ ft., Dia _____ in. to _____ ft.
 Casing height above land surface _____ in., weight _____ lbs./ft. Wall thickness or gauge No. _____
 TYPE OF SCREEN OR PERFORATION MATERIAL:
 1 Steel 3 Stainless steel 5 Fiberglass 7 PVC 10 Asbestos-cement
 2 Brass 4 Galvanized steel 6 Concrete tile 8 RMP (SR) 11 Other (specify) _____
 9 ABS 12 None used (open hole)
 SCREEN OR PERFORATION OPENINGS ARE:
 1 Continuous slot 3 Mill slot 5 Gauzed wrapped 8 Saw cut 11 None (open hole)
 2 Louvered shutter 4 Key punched 6 Wire wrapped 9 Drilled holes
 7 Torch cut 10 Other (specify) _____
 SCREEN-PERFORATED INTERVALS: From _____ ft. to _____ ft., From _____ ft. to _____ ft.
 GRAVEL PACK INTERVALS: From _____ ft. to _____ ft., From _____ ft. to _____ ft.

6 GROUT MATERIAL: Neat cement 2 Cement grout 3 Bentonite 4 Other _____
 Grout intervals: From _____ ft. to 3.0' ft., From _____ ft. to _____ ft., From _____ ft. to _____ ft.
 What is the nearest source of possible contamination:
 1 Septic tank 4 Lateral lines 7 Pit privy 10 Livestock pens 14 Abandoned water well
 2 Sewer lines 5 Cess pool 8 Sewage lagoon 11 Fuel storage 15 Oil well/Gas well
 3 Watertight sewer lines 6 Seepage pit 9 Feedyard 12 Fertilizer storage 16 Other (specify below)
 13 Insecticide storage
 Direction from well? _____ How many feet? _____

| FROM | TO | LITHOLOGIC LOG | FROM | TO | PLUGGING INTERVALS |
|------|----|--------------------------------------|-------------|--------------|--|
| | | <u>Abandoned existing piezometer</u> | <u>0.0'</u> | <u>3.0'</u> | <u>compacted clay soil</u> |
| | | | <u>3.0'</u> | <u>22.6'</u> | <u>Neat cement grout 1.5 bags Portland cement mixed with 30 gallons of water</u> |
| | | | | | <u>6.5' of pipe was pulled</u> |

7 CONTRACTOR'S OR LANDOWNER'S CERTIFICATION: This water well was (1) constructed, (2) reconstructed, or plugged under my jurisdiction and was completed on (mo/day/year) 4/26/05 and this record is true to the best of my knowledge and belief. Kansas Water Well Contractor's License No. N/A This Water Well Record was completed on (mo/day/yr) 6/6/05 under the business name of US Army Corps of Eng - Geol Sect by (signature) _____

OFFICE USE ONLY
T
R
EW
SEC
1/4
1/4
1/4