

## CORRECTION(S) TO WATER WELL RECORD (WWC-5)

(to rectify lacking or incorrect information)

County: Geary

Location listed as:


Location changed to:

Section-Township-Range: None Given30-11S-6EFraction (  $\frac{1}{4}$   $\frac{1}{4}$   $\frac{1}{4}$ ): \_\_\_\_\_NE NW SEOther changes: Initial statements: Riley CountyChanged to: Geary CountyComments: Section, Township, Range, and quarters were determined by projecting normal Public Land Survey System over Ft. Riley.verification method: Latitude and longitude, and Junction City  
1:24,000 topo. map.initials: DRK date: 4/28/2006

1 LOCATION OF WATER WELL: Fraction  $\frac{1}{4}$   $\frac{1}{4}$   $\frac{1}{4}$  Section Number Township Number Range Number  
 County: Riley T S R EW

Distance and direction from nearest town or city street address of well if located within city?  
Lot/Long - 39° 03' 55.581" N 96° 48' 08.617" W

2 WATER WELL OWNER: Ft Riley Directorate of Environment + Safety  
 RR#, St. Address, Box # : Bldg 407 Pershing Ct Board of Agriculture, Division of Water Resources  
 City, State, ZIP Code : Ft Riley KS Application Number:

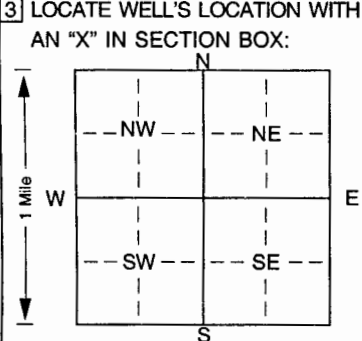

4 DEPTH OF COMPLETED WELL... 57.8 ... ft. ELEVATION: .....

Depth(s) Groundwater Encountered 1..... ft. 2..... ft. 3..... ft.

WELL'S STATIC WATER LEVEL 22.9 ... ft. below land surface measured on mo/day/yr 2/13/06 .....

Pump test data: Well water was ..... ft. after ..... hours pumping ..... gpm

Est. Yield ..... gpm: Well water was ..... ft. after ..... hours pumping ..... gpm

Bore Hole Diameter..... in. to ..... ft., and..... in. to ..... ft.

WELL WATER TO BE USED AS: 5 Public water supply 8 Air conditioning 11 Injection well  
 1 Domestic 3 Feedlot 6 Oil field water supply 9 Dewatering 12 Other (Specify below)  
 2 Irrigation 4 Industrial 7 Domestic (lawn & garden) 10 Monitoring well... Observation Well.

Was a chemical/bacteriological sample submitted to Department? Yes..... No.....; If yes, mo/day/yr sample was submitted Water Well Disinfected? Yes No

5 TYPE OF BLANK CASING USED:

1 Steel 3 RMP (SR) 5 Wrought iron 8 Concrete tile CASING JOINTS: Glued..... Clamped.....  
2 PVO 4 ABS 6 Asbestos-Cement 9 Other (specify below) Welded.....  
 7 Fiberglass Pulled - 5.5' Threaded.....

Blank casing diameter..... 2 .. in. to ..... ft., Dia..... in. to ..... ft., Dia..... in. to ..... ft.  
 Casing height below land surface..... 36" .. in., weight..... lbs./ft. Wall thickness or gauge No.....

TYPE OF SCREEN OR PERFORATION MATERIAL:

1 Steel 3 Stainless steel 5 Fiberglass 7 PVC 10 Asbestos-cement  
 2 Brass 4 Galvanized steel 6 Concrete tile 8 RMP (SR) 11 Other (specify).....  
 9 ABS 12 None used (open hole)

SCREEN OR PERFORATION OPENINGS ARE:

1 Continuous slot 3 Mill slot 5 Gauzed wrapped 8 Saw cut 11 None (open hole)  
 2 Louvered shutter 4 Key punched 6 Wire wrapped 9 Drilled holes  
 7 Torch cut 10 Other (specify)..... ft.

SCREEN-PERFORATED INTERVALS: From..... ft. to ..... ft., From..... ft. to ..... ft.  
 From..... ft. to ..... ft., From..... ft. to ..... ft.

GRAVEL PACK INTERVALS: From..... ft. to ..... ft., From..... ft. to ..... ft.  
 From..... ft. to ..... ft., From..... ft. to ..... ft.

6 GROUT MATERIAL: 1 Neat cement 2 Cement grout 3 Bentonite 4 Other 5% Bentonite - Cement Grout

Grout Intervals: From 57.8 .. ft. to 3 .. ft., From..... ft. to ..... ft., From..... ft. to ..... ft.

What is the nearest source of possible contamination:

1 Septic tank 4 Lateral lines 7 Pit privy 11 Fuel storage 14 Abandoned water well  
 2 Sewer lines 5 Cess pool 8 Sewage lagoon 12 Fertilizer storage 15 Oil well/Gas well  
 3 Watertight sewer lines 6 Seepage pit 9 Feedyard 13 Insecticide storage 16 Other (specify below)  
WATER WELL

Direction from well? SW How many feet? 300' Bldg 3202

FROM	TO	LITHOLOGIC LOG	FROM	TO	PLUGGING INTERVALS
			<u>57.8</u>	<u>3</u>	<u>5% Bentonite - Cement Grout</u>
			<u>3</u>	<u>0</u>	<u>Topsoil</u>

7 CONTRACTOR'S OR LANDOWNER'S CERTIFICATION: This water well was (1) constructed, (2) reconstructed, or (3) plugged under my jurisdiction and was completed on (mo/day/year) 2/14/06 .. and this record is true to the best of my knowledge and belief. Kansas Water Well Contractor's Licence No. .... This Water Well Record was completed on (mo/day/yr) 2/22/06 .. under the business name of USACE by (signature) [Signature]

INSTRUCTIONS: Use typewriter or ball point pen. PLEASE PRESS FIRMLY and PRINT clearly. Please fill in blanks, underline or circle the correct answers. Send top three copies to Kansas Department of Health and Environment, Bureau of Water, Topeka, Kansas 66620-0001. Telephone 785-296-5524. Send one to WATER WELL OWNER and retain one for your records. Fee of \$5.00 for each constructed well.