

CORRECTION(S) TO WATER WELL RECORD (WWC-5)

(to rectify lacking or incorrect information)

County: Geary

Location listed as:

Location changed to:

Section-Township-Range: None Given

29-11S-6E

Fraction (  $\frac{1}{4}$   $\frac{1}{4}$   $\frac{1}{4}$ ): \_\_\_\_\_

E2 E2 SW

Other changes: Initial statements: Riley County

Changed to: Geary County

Comments: Legal description determined by projecting normal Public Land Survey System over Fort Riley.


verification method: Latitude and longitude, and Junction City 1:24,000 topo. map.

initials: DRJ date: 5/23/2006

1 LOCATION OF WATER WELL:	Fraction ¼    ¼    ¼	Section Number	Township Number	Range Number
County: <u>Riley</u>				E/W

Distance and direction from nearest town or city street address of well if located within city?  
Lat/Long 39° 03' 43.311" N 96° 47' 26.524" W

2 WATER WELL OWNER: Ft Riley Directorate of Environment & Safety  
 RR #, St. Address, Box #: Bldg 407 Pershing Ct  
 City, State, ZIP Code: Ft Riley KS  
 Board of Agriculture, Division of Water Resources  
 Application Number:

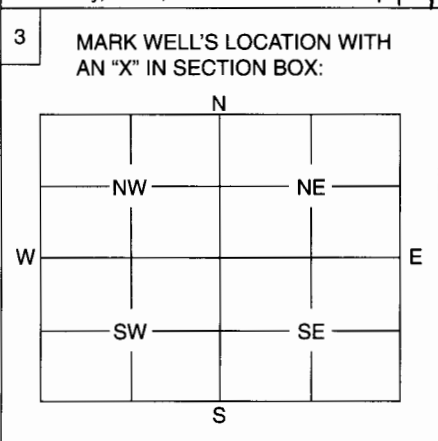

4 DEPTH OF WELL ..... 42.9 ..... ft.  
 WELL'S STATIC WATER LEVEL ..... 42.5 ..... ft.  
 WELL WAS USED AS:

1 Domestic	5 Public Water Supply	9 Dewatering
2 Irrigation	6 Oil Field Water Supply	<u>10 Monitoring Well</u>
3 Feedlot	7 Domestic (Lawn & Garden)	11 Injection Well
4 Industrial	8 Air Conditioning	12 Other .....

Was a chemical / bacteriological sample submitted to Department? Yes ..... No .....  
 If yes, mo/day/yr sample was submitted .....

Water Well Disinfected: Yes ..... No .....

5 TYPE OF BLANK CASING USED:

1 Steel	3 RMP (SR)	5 Wrought	7 Fiberglass	9 Other (Specify below)
<u>2 PVC</u>	4 ABS	6 Asbestos-Cement	8 Concrete Tile	

Blank casing diameter ..... 2 ..... in.      Was casing pulled?    Yes X ..... No .....      If yes, how much 5.2 .....  
 Casing height above or below land surface ..... 3 ft. ....

6 GROUT PLUG MATERIAL:    1 Neat cement    2 Cement grout    3 Bentonite    4 Other 5% Bentonite Cement Grout

Grout Plug Intervals:    From 42.9 ft. to 3 ft.,    From ..... ft. to ..... ft.,    From ..... ft. to ..... ft.

What is the nearest source of possible contamination:

1 Septic tank	6 Seepage pit	11 Fuel storage	16 Other (specify below)
2 Sewer lines	7 Pit privy	12 Fertilizer storage	
3 Watertight sewer lines	8 Sewage lagoon	13 Insecticide storage	
4 Lateral lines	9 Feedyard	14 Abandoned water well	
5 Cess pool	<u>10 Livestock pens</u>	15 Oil well/Gas well	

Direction from well? ..... N .....      How many feet? ..... 300 .....

FROM	TO	PLUGGING MATERIALS
<u>42.9'</u>	<u>3'</u>	<u>5% Bentonite-Cement Grout</u>
<u>3'</u>	<u>0'</u>	<u>Topsoil</u>

7 CONTRACTOR'S OR LANDOWNER'S CERTIFICATION: This water well was plugged under my jurisdiction and was completed on (mo/day/year) 2/14/06 and this record is true to the best of my knowledge and belief. Kansas Water Well Contractor's License No. N/A This Water Well Record was completed on (mo/day/year) 2/24/06 under the business name of USACE by (signature) Jeanne Decker

INSTRUCTIONS: Use typewriter or ball point pen. Please press firmly and print clearly. Please fill in blanks, underline or circle the correct answers. Send top three copies to Kansas Department of Health and Environment, Bureau of Water, Geology Section, 1000 SW Jackson St., Ste. 420, Topeka, Kansas 66612-1367. Telephone: 785/296-5522. Send one to Water Well Owner and retain one for your records.