

CORRECTION(S) TO WATER WELL RECORD (WWC-5)

(to rectify lacking or incorrect information)

Location listed as:

Section-Township-Range: None Given

Fraction (  $\frac{1}{4}$   $\frac{1}{4}$   $\frac{1}{4}$ ): \_\_\_\_\_

County: Geary

Location changed to:

29-115-6E

NW SE NE SW

Other changes: Initial statements: Riley County

Changed to: Geary County

Comments: Legal description determined by projecting normal  
Public Land Survey System over Fort Riley.

verification method: Latitude and longitude, and Junction City  
1:24,000 topo. map.

initials: ARL date: 5/23/2006


submitted by: Kansas Geological Survey, Data Resources Library, 1930 Constant Ave., Lawrence, KS 66047-3726

to: Kansas Dept of Health & Environment, Bureau of Water, 1000 SW Jackson, Suite 420, Topeka, KS 66612-1367.

<b>1</b> LOCATION OF WATER WELL:	Fraction	Section Number	Township Number	Range Number
County: <u>Riley</u>	$\frac{1}{4}$ $\frac{1}{4}$ $\frac{1}{4}$			E/W

Distance and direction from nearest town or city street address of well if located within city?  
Lat/Long 39° 03' 46.951" N 96° 47' 27.758" W

**2** WATER WELL OWNER: At Riley Directorate of Environment & Safety  
 RR #, St. Address, Box # Bldg 407 Pershing Ct  
 City, State, ZIP Code : At Riley KS Board of Agriculture, Division of Water Resources  
 Application Number:

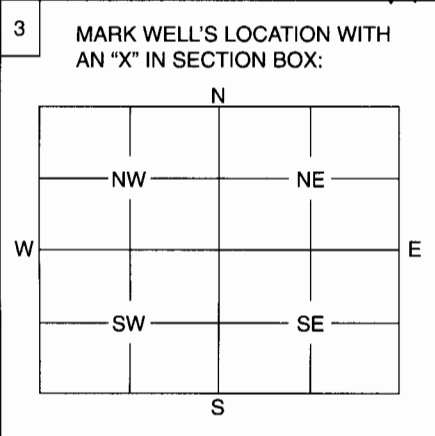

**4** DEPTH OF WELL 49.1 ft.  
 WELL'S STATIC WATER LEVEL 42.2 ft.  
 WELL WAS USED AS:

1 Domestic	5 Public Water Supply	9 Dewatering
2 Irrigation	6 Oil Field Water Supply	<u>10 Monitoring Well</u>
3 Feedlot	7 Domestic (Lawn & Garden)	11 Injection Well
4 Industrial	8 Air Conditioning	12 Other .....

Was a chemical / bacteriological sample submitted to Department? Yes ..... No .....  
 If yes, mo/day/yr sample was submitted .....

Water Well Disinfected: Yes ..... No .....

**5** TYPE OF BLANK CASING USED:

1 Steel	3 RMP (SR)	5 Wrought	7 Fiberglass	9 Other (Specify below)
<u>2 PVC</u>	4 ABS	6 Asbestos-Cement	8 Concrete Tile	

Blank casing diameter 2 in. Was casing pulled? Yes X No ..... If yes, how much 4.4  
 Casing height above or below land surface 3.0 ft

**6** GROUT PLUG MATERIAL: 1 Neat cement 2 Cement grout 3 Bentonite 4 Other 5% Bentonite-Cement Grout  
 Grout Plug Intervals: From 49.1 ft. to 3 ft., From ..... ft. to ..... ft., From ..... to ..... ft.

What is the nearest source of possible contamination:

1 Septic tank	6 Seepage pit	11 Fuel storage	16 Other (specify below)
2 Sewer lines	7 Pit privy	12 Fertilizer storage	
3 Watertight sewer lines	8 Sewage lagoon	13 Insecticide storage	
4 Lateral lines	9 Feedyard	14 Abandoned water well	
5 Cess pool	<u>10 Livestock pens</u>	15 Oil well/Gas well	

Direction from well? N How many feet? 500

FROM	TO	PLUGGING MATERIALS
<u>49.1</u>	<u>3</u>	<u>5% Bentonite-Cement Grout</u>
<u>3</u>	<u>0</u>	<u>Topsoil</u>

**7** CONTRACTOR'S OF LANDOWNER'S CERTIFICATION: This water well was plugged under my jurisdiction and was completed on (mo/day/year) 2/14/06 and this record is true to the best of my knowledge and belief. Kansas Water Well Contractor's License No. 2124106 under the business name of USACE This Water Well Record was completed on (mo/day/year) 2/14/06 by (signature) Jeanne D. Dwyer

INSTRUCTIONS: Use typewriter or ball point pen. Please press firmly and print clearly. Please fill in blanks, underline or circle the correct answers. Send top three copies to Kansas Department of Health and Environment, Bureau of Water, Geology Section, 1000 SW Jackson St., Ste. 420, Topeka, Kansas 66612-1367. Telephone: 785/296-5522. Send one to Water Well Owner and retain one for your records.