

CORRECTION(S) TO WATER WELL RECORD (WWC-5)
(to rectify lacking or incorrect information)

Location listed as:

Section-Township-Range: None Given

Fraction ($\frac{1}{4}$ $\frac{1}{4}$ $\frac{1}{4}$): _____

County: Geary
Location changed to:

29-11S-6E

SW SE NE SW

Other changes: Initial statements: Riley County

Changed to: Geary County

Comments: Legal description determined by projecting normal
Public Land Survey System over Fort Riley.


verification method: Latitude and longitude, and Junction City
1:24,000 topo. map.

initials: DRJ date: 5/23/2006

1 LOCATION OF WATER WELL:	Fraction	Section Number	Township Number	Range Number
County: <u>Riley</u>	¼ ¼ ¼			E/W

Distance and direction from nearest town or city street address of well if located within city?
Lat/Long 39°03' 45.147" N 96° 47' 27.482" W

2 WATER WELL OWNER: FF Riley Directorate of Environment & Safety
 RR #, St. Address, Box #: Bldg 407 Pershing Ct
 City, State, ZIP Code: FF Riley KS Board of Agriculture, Division of Water Resources
 Application Number:

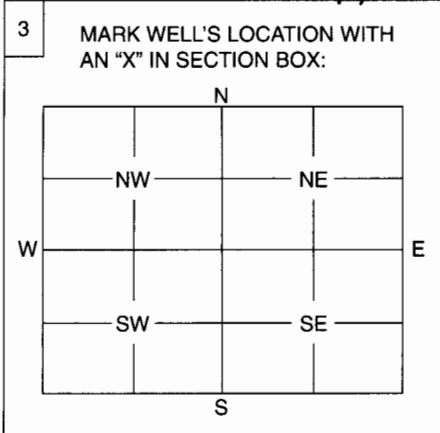

4 DEPTH OF WELL 45.0' ft.
 WELL'S STATIC WATER LEVEL 36.9' ft.
 WELL WAS USED AS:

1 Domestic	5 Public Water Supply	9 Dewatering
2 Irrigation	6 Oil Field Water Supply	10 Monitoring Well
3 Feedlot	7 Domestic (Lawn & Garden)	11 Injection Well
4 Industrial	8 Air Conditioning	12 Other

Was a chemical / bacteriological sample submitted to Department? Yes No
 If yes, mo/day/yr sample was submitted

Water Well Disinfected: Yes No

5 TYPE OF BLANK CASING USED:

1 Steel	3 RMP (SR)	5 Wrought	7 Fiberglass	9 Other (Specify below)
2 PVC	4 ABS	6 Asbestos-Cement	8 Concrete Tile	

Blank casing diameter in. Was casing pulled? Yes X No If yes, how much 6.9'
 Casing height above of below land surface 4.9' ft

6 GROUT PLUG MATERIAL: 1 Neat cement 2 Cement grout 3 Bentonite 4 Other 5% Bentonite-Cement Grout
 Grout Plug Intervals: From 45.0 ft. to 3 ft., From ft. to ft., From to ft.

What is the nearest source of possible contamination:

1 Septic tank	6 Seepage pit	11 Fuel storage	16 Other (specify below)
2 Sewer lines	7 Pit privy	12 Fertilizer storage	
3 Watertight sewer lines	8 Sewage lagoon	13 Insecticide storage	
4 Lateral lines	9 Feedyard	14 Abandoned water well	
5 Cess pool	10 Livestock pens	15 Oil well/Gas well	

Direction from well? N How many feet? 500

FROM	TO	PLUGGING MATERIALS
<u>45.0</u>	<u>3</u>	<u>5% Bentonite-Cement Grout</u>
<u>3</u>	<u>0</u>	<u>Topsoil</u>

7 CONTRACTOR'S OF LANDOWNER'S CERTIFICATION: This water well was plugged under my jurisdiction and was completed on (mo/day/year) 2/14/06 and this record is true to the best of my knowledge and belief. Kansas Water Well Contractor's License No. N/A This Water Well Record was completed on (mo/day/year) 2/24/06 under the business name of USACE by (signature) Jennifer Denser

INSTRUCTIONS: Use typewriter or ball point pen. Please press firmly and print clearly. Please fill in blanks, underline or circle the correct answers. Send top three copies to Kansas Department of Health and Environment, Bureau of Water, Geology Section, 1000 SW Jackson St., Ste. 420, Topeka, Kansas 66612-1367. Telephone: 785/296-5522. Send one to Water Well Owner and retain one for your records.