

CORRECTION(S) TO WATER WELL RECORD (WWC-5)  
(to rectify lacking or incorrect information)

County: Geary

Location listed as:

Location changed to:

Section-Township-Range: None Given

28-11S-6E

Fraction (  $\frac{1}{4}$   $\frac{1}{4}$   $\frac{1}{4}$ ): \_\_\_\_\_

S2 SW NE SE

Other changes: Initial statements: \_\_\_\_\_

Changed to: \_\_\_\_\_

Comments: Legal description determined by projecting normal  
Public Land Survey System over Fort Riley.

verification method: Latitude and longitude, and Junction City  
1:24,000 topo. map.


initials: ARR date: 6/1/2006

LOCATION  
 39° 03' 45.482" N  
 96° 45' 55.129" W

1 LOCATION OF WATER WELL: Fraction  $\frac{1}{4}$   $\frac{1}{4}$   $\frac{1}{4}$  Section Number Township Number Range Number  
 County: Geary E/W

Distance and direction from nearest town or city street address of well if located within city?

2 WATER WELL OWNER: Ft Riley Environmental Division-DPW Attn: Dale Jones  
 RR #, St. Address, Box #: 407 Pershing Ct. Board of Agriculture, Division of Water Resources  
 City, State, ZIP Code: Ft Riley KS 66642 Application Number:

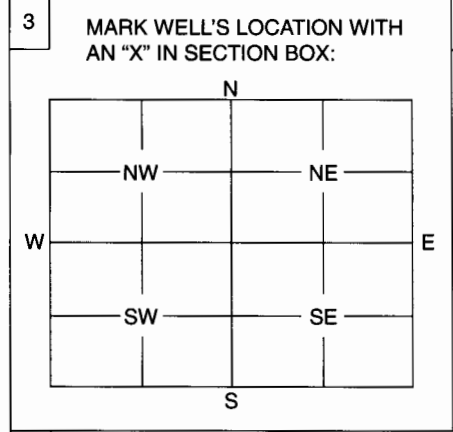

4 DEPTH OF WELL 20.3 ft.  
 WELL'S STATIC WATER LEVEL 16.2 ft.  
 WELL WAS USED AS:  
 1 Domestic 5 Public Water Supply 9 Dewatering  
 2 Irrigation 6 Oil Field Water Supply 10 Monitoring well  
 3 Feedlot 7 Domestic (Lawn & Garden) 11 Injection Well  
 4 Industrial 8 Air Conditioning 12 Other .....

Was a chemical / bacteriological sample submitted to Department? Yes ..... No X.....  
 If yes, mo/day/yr sample was submitted .....

Water Well Disinfected: Yes ..... No X.....

5 TYPE OF BLANK CASING USED:  
 1 Steel 3 RMP (SR) 5 Wrought 7 Fiberglass 9 Other (Specify below)  
 2 PVC 4 ABS 6 Asbestos-Cement 8 Concrete Tile .....

Blank casing diameter 1.8 in. Was casing pulled? Yes X No ..... If yes, how much 4.2 .....

Casing height above or below land surface 14.4 3.6 in.

6 GROUT PLUG MATERIAL: 1 Neat cement 2 Cement grout 3 Bentonite 4 Other .....

Grout Plug Intervals: From 3 ft. to 20.3 ft., From ..... ft. to ..... ft., From ..... to ..... ft.

What is the nearest source of possible contamination:  
 1 Septic tank 6 Seepage pit 11 Fuel storage 16 Other (specify below)  
 2 Sewer lines 7 Pit privy 12 Fertilizer storage Air Field  
 3 Watertight sewer lines 8 Sewage lagoon 13 Insecticide storage  
 4 Lateral lines 9 Feedyard 14 Abandoned water well  
 5 Cess pool 10 Livestock pens 15 Oil well/Gas well

Direction from well? S How many feet? 1000

FROM	TO	PLUGGING MATERIALS
0	3'	Native Soil
3'	20.3'	Neat Cement

7 CONTRACTOR'S OR LANDOWNER'S CERTIFICATION: This water well was plugged under my jurisdiction and was completed on (mo/day/year) 04/19/06 and this record is true to the best of my knowledge and belief. Kansas Water Well Contractor's License No. NA This Water Well Record was completed on (mo/day/year) 4/10/06 under the business name of USACE  
 by (signature) Arthur E. Woody

INSTRUCTIONS: Use typewriter or ball point pen. Please press firmly and print clearly. Please fill in blanks, underline or circle the correct answers. Send top three copies to Kansas Department of Health and Environment, Bureau of Water, Geology Section, 1000 SW Jackson St., Ste. 420, Topeka, Kansas 66612-1367. Telephone: 785/296-5522. Send one to Water Well Owner and retain one for your records.