

CORRECTION(S) TO WATER WELL RECORD (WWC-5)

(to rectify lacking or incorrect information)

County: Geary

Location listed as:

Section-Township-Range: None Given

Fraction ($\frac{1}{4}$ $\frac{1}{4}$ $\frac{1}{4}$): _____

Location changed to:

27-115-6E

N2 N2 SW

Other changes: Initial statements: _____

Changed to: _____

Comments: Legal description determined by projecting normal
Public Land Survey System over Fort Riley.

verification method: Latitude and longitude, and Junction City
1:24,000 topo. map.

initials: DRJ date: 6/2/2006


submitted by: Kansas Geological Survey, Data Resources Library, 1930 Constant Ave., Lawrence, KS 66047-3726
to: Kansas Dept of Health & Environment, Bureau of Water, 1000 SW Jackson, Suite 420, Topeka, KS 66612-1367.

LOCATION
 390 03' 54.119" N
 96° 45' 25.255" W

1	LOCATION OF WATER WELL:	Fraction	Section	Number	Township	Number	Range	Number
	County: <u>Geary</u>	$\frac{1}{4}$ $\frac{1}{4}$ $\frac{1}{4}$						E/W

Distance and direction from nearest town or city street address of well if located within city?

2 WATER WELL OWNER: Ft Riley Environmental Division - DPW
 RR #, St. Address, Box #: ATTN: Dave Jones
 City, State, ZIP Code: 407 Pershing Ct. Ft Riley KS 66442
 Board of Agriculture, Division of Water Resources
 Application Number:

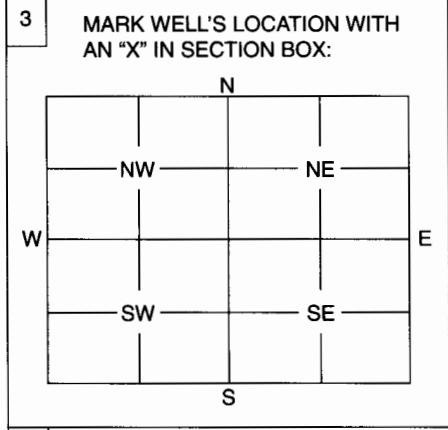

4 DEPTH OF WELL 30.6 ft.
 WELL'S STATIC WATER LEVEL 24.6 ft.
 WELL WAS USED AS:

1 Domestic	5 Public Water Supply	9 Dewatering
2 Irrigation	6 Oil Field Water Supply	10 <u>Monitoring Well</u>
3 Feedlot	7 Domestic (Lawn & Garden)	11 Injection Well
4 Industrial	8 Air Conditioning	12 Other

Was a chemical / bacteriological sample submitted to Department? Yes No X
 If yes, mo/day/yr sample was submitted

Water Well Disinfected: Yes No X

5 TYPE OF BLANK CASING USED:

<u>1 Steel</u>	3 RMP (SR)	5 Wrought	7 Fiberglass	9 Other (Specify below)
2 ABS	4 ABS	6 Asbestos-Cement	8 Concrete Tile	

Blank casing diameter 2 in. Was casing pulled? Yes X No If yes, how much 7.2'
 Casing height above or below land surface 3.0' in. 4'

6 GROUT PLUG MATERIAL: 1 Neat cement 2 Cement grout 3 Bentonite 4 Other

Grout Plug Intervals: From 3 ft. to 30.6 ft., From ft. to ft., From to ft.

What is the nearest source of possible contamination:

1 Septic tank	6 Seepage pit	11 Fuel storage
2 Sewer lines	7 Pit privy	12 Fertilizer storage
3 Watertight sewer lines	8 Sewage lagoon	13 Insecticide storage
4 Lateral lines	9 Feedyard	14 Abandoned water well
5 Cess pool	10 Livestock pens	15 Oil well/Gas well

Direction from well? S How many feet? 500

16 Other (specify below)
race track

FROM	TO	PLUGGING MATERIALS
0	3'	Native Soil
3'	30.6'	Neat Cement

7 CONTRACTOR'S OR LANDOWNER'S CERTIFICATION: This water well was plugged under my jurisdiction and was completed on (mo/day/year) 3/23/06 and this record is true to the best of my knowledge and belief. Kansas Water Well Contractor's License No. 7107106 under the business name of N/A This Water Well Record was completed on (mo/day/year) 3/23/06 by (signature) Arthur P. Wood USAACE

INSTRUCTIONS: Use typewriter or ball point pen. Please press firmly and print clearly. Please fill in blanks, underline or circle the correct answers. Send top three copies to Kansas Department of Health and Environment, Bureau of Water, Geology Section, 1000 SW Jackson St., Ste. 420, Topeka, Kansas 66612-1367. Telephone: 785/296-5522. Send one to Water Well Owner and retain one for your records.