

CORRECTION(S) TO WATER WELL RECORD (WWC-5)
(to rectify lacking or incorrect information)

Location listed as:

Section-Township-Range: None Given

Fraction ($\frac{1}{4}$ $\frac{1}{4}$ $\frac{1}{4}$): _____

County: Geary

Location changed to:

27-115-6E

W2 W2 E2 SW

Other changes: Initial statements: _____

Changed to: _____

Comments: Legal description determined by projecting normal
Public Land Survey System over Fort Riley.

verification method: Latitude and longitude, and Junction City
1:24,000 topo. map.

initials: DRL date: 6/5/2006

submitted by: Kansas Geological Survey, Data Resources Library, 1930 Constant Ave., Lawrence, KS 66047-3726
to: Kansas Dept of Health & Environment, Bureau of Water, 1000 SW Jackson, Suite 420, Topeka, KS 66612-1367.

LOCATION
267940.35N
1665351.97E

Ks State Plane Ft.


39°03'44.49"N
96°45'24.13"W

WATER WELL PLUGGING RECORD Form WWC-5P KSA 82a-1212 ID No. FP 96-02C

1	LOCATION OF WATER WELL:	Fraction 1/4 1/4 1/4	Section	Number	Township	Number	Range	Number
County: <u>Geary</u> E/W								

Distance and direction from nearest town or city street address of well if located within city?

2 WATER WELL OWNER: Ft Riley Environmental Division - DPW
 RR #, St. Address, Box #: ATTN: Dave Jones
 City, State, ZIP Code: 407 Pershing Ct. Ft Riley, KS, 66442 Board of Agriculture, Division of Water Resources
 Application Number:

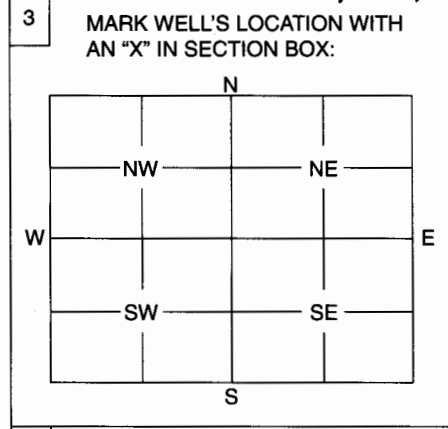

4 DEPTH OF WELL 67.3 ft.
 WELL'S STATIC WATER LEVEL 21.9 ft.
 WELL WAS USED AS:
 1 Domestic 5 Public Water Supply 9 Dewatering
 2 Irrigation 6 Oil Field Water Supply 10 Monitoring Well
 3 Feedlot 7 Domestic (Lawn & Garden) 11 Injection Well
 4 Industrial 8 Air Conditioning 12 Other

Was a chemical / bacteriological sample submitted to Department? Yes No X.....
 If yes, mo/day/yr sample was submitted

Water Well Disinfected: Yes No X.....

5 TYPE OF BLANK CASING USED:
 1 Steel 3 RMP (SR) 5 Wrought 7 Fiberglass 9 Other (Specify below)
2 PVC 4 ABS 6 Asbestos-Cement 8 Concrete Tile

Blank casing diameter 2 in. Was casing pulled? Yes X No If yes, how much 7'
 Casing height above or below land surface 48 in.

6 GROUT PLUG MATERIAL: 1 Neat cement 2 Cement grout 3 Bentonite 4 Other

Grout Plug Intervals: From 3 ft. to 67.3 ft., From ft. to ft., From to ft.

What is the nearest source of possible contamination:
 1 Septic tank 6 Seepage pit 11 Fuel storage 16 Other (specify below)
 2 Sewer lines 7 Pit privy 12 Fertilizer storage Facetrack
 3 Watertight sewer lines 8 Sewage lagoon 13 Insecticide storage
 4 Lateral lines 9 Feedyard 14 Abandoned water well
 5 Cess pool 10 Livestock pens 15 Oil well/Gas well

Direction from well? N How many feet? 300

FROM	TO	PLUGGING MATERIALS
<u>0</u>	<u>3'</u>	<u>Native Soil</u>
<u>3'</u>	<u>67.3'</u>	<u>Neat Cement</u>

7 CONTRACTOR'S OF LANDOWNER'S CERTIFICATION: This water well was plugged under my jurisdiction and was completed on (mo/day/year) 3/24/06 and this record is true to the best of my knowledge and belief. Kansas Water Well Contractor's License No. N/A This Water Well Record was completed on (mo/day/year) 4/10/06 under the business name of USACE
 by (signature) [Signature]

INSTRUCTIONS: Use typewriter or ball point pen. Please press firmly and print clearly. Please fill in blanks, underline or circle the correct answers. Send top three copies to Kansas Department of Health and Environment, Bureau of Water, Geology Section, 1000 SW Jackson St., Ste. 420, Topeka, Kansas 66612-1367. Telephone: 785/296-5522. Send one to Water Well Owner and retain one for your records.