

CORRECTION(S) TO WATER WELL RECORD (WWC-5)
(to rectify lacking or incorrect information)

Location listed as:

Section-Township-Range: None Given

Fraction ($\frac{1}{4}$ $\frac{1}{4}$ $\frac{1}{4}$): _____

County: Geary

Location changed to:

27-115-6E

N2 N2 NW NW NE

Other changes: Initial statements: No county name given.

Changed to: Geary County

Comments: Section, township, and range determined by projecting normal Kansas survey system over Fort Riley.

verification method: Latitude & longitude, and Junction City 1:24,000 topo. map.


initials: DRK date: 6/23/2006

LOCATION
 39° 04' 23.814" N
 96° 45' 05.268" W

| | | | | | |
|---------|-------------------------|-------------|----------------|-----------------|--------------|
| 1 | LOCATION OF WATER WELL: | Fraction | Section Number | Township Number | Range Number |
| County: | | 1/4 1/4 1/4 | | | E/W |

Distance and direction from nearest town or city street address of well if located within city?

2 WATER WELL OWNER: Ft Riley Environmental Division Attn: Bob Anderson
 RR #, St. Address, Box #: Bldg 407 Penning Court Board of Agriculture, Division of Water Resources
 City, State, ZIP Code: Ft Riley KS 66442 Application Number:

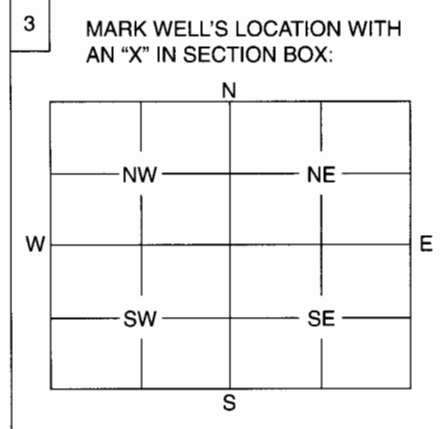

4 DEPTH OF WELL 27.7 ft. BLS
 WELL'S STATIC WATER LEVEL NC ft. Not Collected

WELL WAS USED AS:

| | | |
|--------------|----------------------------|---------------------------|
| 1 Domestic | 5 Public Water Supply | 9 Dewatering |
| 2 Irrigation | 6 Oil Field Water Supply | 10 <u>Monitoring Well</u> |
| 3 Feedlot | 7 Domestic (Lawn & Garden) | 11 <u>Injection Well</u> |
| 4 Industrial | 8 Air Conditioning | 12 Other |

Was a chemical / bacteriological sample submitted to Department? Yes No X
 If yes, mo/day/yr sample was submitted

Water Well Disinfected: Yes No X

5 TYPE OF BLANK CASING USED:

| | | | | |
|----------------|------------|-------------------|-----------------|-------------------------|
| <u>1 Steel</u> | 3 RMP (SR) | 5 Wrought | 7 Fiberglass | 9 Other (Specify below) |
| 2 PVC | 4 ABS | 6 Asbestos-Cement | 8 Concrete Tile | |

Blank casing diameter 2 in. Was casing pulled? Yes X No If yes, how much 3'
 Casing height above 2 below land surface 30 in. 36"

6 GROUT PLUG MATERIAL: 1 Neat cement 2 Cement grout 3 Bentonite 4 Other

Grout Plug Intervals: From 27.7 ft. to 3.0 ft., From ft. to ft., From to ft.

What is the nearest source of possible contamination:

| | | | |
|--------------------------|-------------------|-------------------------|--------------------------|
| 1 Septic tank | 6 Seepage pit | 11 Fuel storage | 16 Other (specify below) |
| 2 Sewer lines | 7 Pit privy | 12 Fertilizer storage | |
| 3 Watertight sewer lines | 8 Sewage lagoon | 13 Insecticide storage | |
| 4 Lateral lines | 9 Feedyard | 14 Abandoned water well | |
| 5 Cess pool | 10 Livestock pens | 15 Oil well/Gas well | |

Direction from well? How many feet?

| FROM | TO | PLUGGING MATERIALS |
|------|-----|--------------------|
| 27.7 | 3.0 | Neat Cement |
| | | |
| | | |
| | | |
| | | |

7 CONTRACTOR'S OF LANDOWNER'S CERTIFICATION: This water well was plugged under my jurisdiction and was completed on (mo/day/year) 4/17/06 and this record is true to the best of my knowledge and belief. Kansas Water Well Contractor's License No. N/A This Water Well Record was completed on (mo/day/year) 4/25/06 under the business name of PS&AF by (signature) Robert E. Ward

INSTRUCTIONS: Use typewriter or ball point pen. Please press firmly and print clearly. Please fill in blanks, underline or circle the correct answers. Send top three copies to Kansas Department of Health and Environment, Bureau of Water, Geology Section, 1000 SW Jackson St., Ste. 420, Topeka, Kansas 66612-1367. Telephone: 785/296-5522. Send one to Water Well Owner and retain one for your records.