

CORRECTION(S) TO WATER WELL RECORD (WWC-5)

(to rectify lacking or incorrect information)

County: Geary

Location listed as:

Section-Township-Range: None Given

Fraction (  $\frac{1}{4}$   $\frac{1}{4}$   $\frac{1}{4}$ ): \_\_\_\_\_

Location changed to:

32 - 11 S - 6 E

NW NE NE NE

Other changes: Initial statements: \_\_\_\_\_

Changed to: \_\_\_\_\_

Comments: Section, township, and range determined by projecting normal Kansas survey system over Fort Riley.

verification method: Latitude & longitude, and Junction City 1:24,000 topo. map.

initials: QRL date: 2/12/2007


266231.05 N  
1658234.96 E

KANSAS State Plan.  
NAD 83 1501 North Feet  
WATER WELL PLUGGING RECORD Form WWC-5P KSA 82a-1212 ID NO. DCF-03-50a  
Geographic Coord: N 39 03 28.55 E 96 46 54.64 99-386

1	LOCATION OF WATER WELL:	Fraction	Section Number	Township Number	Range Number
	County: <u>Geary</u>	$\frac{1}{4}$ $\frac{1}{4}$ $\frac{1}{4}$			E/W

Distance and direction from nearest town or city street address of well if located within city?

2 WATER WELL OWNER: F+ Riley Environmental Division: Attn Bob Anderson  
 RR #, St. Address, Box #: Bldg 407 Pershing Ct. Board of Agriculture, Division of Water Resources  
 City, State, ZIP Code: F+ Riley, KS 66642 Application Number:

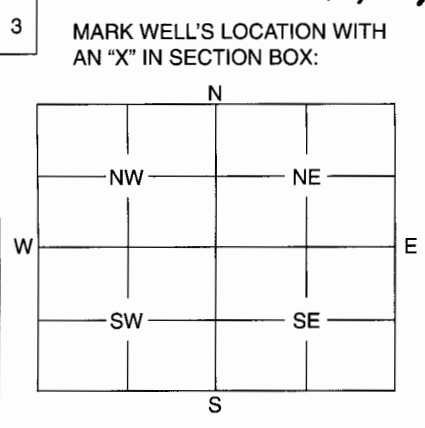

4 DEPTH OF WELL ..... 25.8 ..... ft. B65  
 WELL'S STATIC WATER LEVEL 22.3 ..... ft. B65

WELL WAS USED AS:

1 Domestic	5 Public Water Supply	9 Dewatering
2 Irrigation	6 Oil Field Water Supply	<u>10 Monitoring Well</u>
3 Feedlot	7 Domestic (Lawn & Garden)	11 Injection Well
4 Industrial	8 Air Conditioning	12 Other .....

Was a chemical / bacteriological sample submitted to Department? Yes ..... No X  
 If yes, mo/day/yr sample was submitted ..... NA .....

Water Well Disinfected: Yes ..... No X .....

5 TYPE OF BLANK CASING USED:

<u>1 Steel</u>	3 RMP (SR)	5 Wrought	7 Fiberglass	9 Other (Specify below)
2 PVC	4 ABS	6 Asbestos-Cement	8 Concrete Tile	

Blank casing diameter ..... in. Was casing pulled? Yes X No ..... If yes, how much ..... BA 30' 5.5'  
 Casing height above or below land surface ..... 3.6 ..... in.

6 GROUT PLUG MATERIAL: 1 Neat cement   2 Cement grout   3 Bentonite   4 Other .....

Grout Plug Intervals: From ..... 3 ..... ft. to ..... 25.8 ..... ft., From ..... ft. to ..... ft., From ..... to ..... ft.

What is the nearest source of possible contamination:

1 Septic tank	6 Seepage pit	11 Fuel storage	16 Other (specify below)
2 Sewer lines	7 Pit privy	12 Fertilizer storage	
3 Watertight sewer lines	8 Sewage lagoon	13 Insecticide storage	
4 Lateral lines	9 Feedyard	14 Abandoned water well	
5 Cess pool	10 Livestock pens	15 Oil well/Gas well	

Direction from well? ..... How many feet? .....

FROM	TO	PLUGGING MATERIALS
<u>0</u>	<u>3</u>	<u>Native Soil</u>
<u>3</u>	<u>25.8</u>	<u>Neat Cement Grout</u>

7 CONTRACTOR'S OF LANDOWNER'S CERTIFICATION: This water well was plugged under my jurisdiction and was completed on (mo/day/year) ..... 18 July 2006 ..... and this record is true to the best of my knowledge and belief. Kansas Water Well Contractor's License No. NA ..... This Water Well Record was completed on (mo/day/year) 21 July 2006 under the business name of US Army Corps of Engineers by (signature) [Signature]

INSTRUCTIONS: Use typewriter or ball point pen. Please press firmly and print clearly. Please fill in blanks, underline or circle the correct answers. Send top three copies to Kansas Department of Health and Environment, Bureau of Water, Geology Section, 1000 SW Jackson St., Ste. 420, Topeka, Kansas 66612-1367. Telephone: 785/296-5522. Send one to Water Well Owner and retain one for your records.