

CORRECTION(S) TO WATER WELL RECORD (WWC-5)

(to rectify lacking or incorrect information)

Location listed as:

Section-Township-Range: None GivenFraction ($\frac{1}{4}$ $\frac{1}{4}$ $\frac{1}{4}$): _____County: Geary

Location changed to:

29-11S-6ESE NW SE SW

Other changes: Initial statements: _____

Changed to: _____

Comments: Section, township, and range determined by projecting normal Kansas survey system over Fort Riley.verification method: Latitude & longitude, and Junction City
1:24,000 topo. map.initials: ORA date: 2/14/2007


267292.94 N
1655302.85 E

KANSAS STATE PLANE
NAD 83 1501 N Feet E 96 47 31.63
WATER WELL PLUGGING RECORD Form WWC-5P KSA 82a-1212 ID NO. DCF96-33 P2
Geographic Coord. N39 03 39.43

1 LOCATION OF WATER WELL: Fraction Section Number Township Number Range Number
County: Geary 1/4 1/4 1/4 E/W

Distance and direction from nearest town or city street address of well if located within city?

2 WATER WELL OWNER: Ft Riley Environmental Division: Attn Bob Anderson
RR #, St. Address, Box #: Bldg 407 Pershing Ct Board of Agriculture, Division of Water Resources
City, State, ZIP Code: Ft Riley, KS 66442 Application Number:

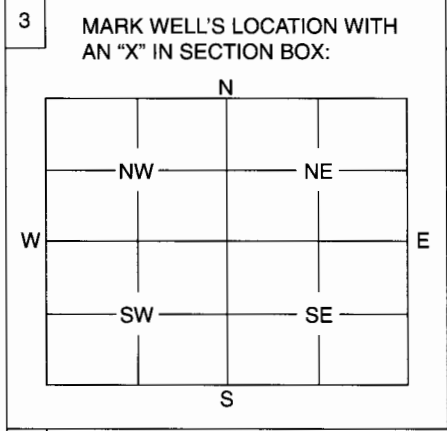

4 DEPTH OF WELL 16 ft. BGS
WELL'S STATIC WATER LEVEL 1.8 ft. BGS
WELL WAS USED AS:
1 Domestic 2 Irrigation 3 Feedlot 4 Industrial 5 Public Water Supply 6 Oil Field Water Supply 7 Domestic (Lawn & Garden) 8 Air Conditioning 9 Dewatering 10 Monitoring Well 11 Injection Well 12 Other
Was a chemical / bacteriological sample submitted to Department? Yes No X
If yes, mo/day/yr sample was submitted NA
Water Well Disinfected: Yes No X

5 TYPE OF BLANK CASING USED:
1 Steel 2 PVC 3 RMP (SR) 4 ABS 5 Wrought 6 Asbestos-Cement 7 Fiberglass 8 Concrete Tile 9 Other (Specify below) BA
Blank casing diameter 1 1/2 in. Was casing pulled? Yes X No If yes, how much 3.0 6.0'
Casing height above or below land surface 36" in.

6 GROUT PLUG MATERIAL: Neat cement 2 Cement grout 3 Bentonite 4 Other
Grout Plug Intervals: From 3 ft. to 16 ft., From ft. to ft., From to ft.
What is the nearest source of possible contamination:
1 Septic tank 2 Sewer lines 3 Watertight sewer lines 4 Lateral lines 5 Cess pool 6 Seepage pit 7 Pit privy 8 Sewage lagoon 9 Feedyard 10 Livestock pens 11 Fuel storage 12 Fertilizer storage 13 Insecticide storage 14 Abandoned water well 15 Oil well/Gas well 16 Other (specify below)
Direction from well? How many feet?

FROM	TO	PLUGGING MATERIALS
<u>0</u>	<u>3</u>	<u>Native Soil</u>
<u>3</u>	<u>16</u>	<u>Neat Cement</u>

7 CONTRACTOR'S OF LANDOWNER'S CERTIFICATION: This water well was plugged under my jurisdiction and was completed on (mo/day/year) 06 July 2009 and this record is true to the best of my knowledge and belief. Kansas Water Well Contractor's License No. NA This Water Well Record was completed on (mo/day/year) 24 July 2009 under the business name of US Army Corps of Engineers by (signature) [Signature]

INSTRUCTIONS: Use typewriter or ball point pen. Please press firmly and print clearly. Please fill in blanks, underline or circle the correct answers. Send top three copies to Kansas Department of Health and Environment, Bureau of Water, Geology Section, 1000 SW Jackson St., Ste. 420, Topeka, Kansas 66612-1367. Telephone: 785/296-5522. Send one to Water Well Owner and retain one for your records.