CORRECTION(S) TO WATER WELL RECORD (WWC-5)
(to rectify lacking or incorrect information)

County: Riley

Location listed as:	**Location changed to:**
Section-Township-Range: None Given	14-11S-6E
Fraction (¼ ¼ ¼):	S2 NW NW

Other changes: Initial statements: _____

Changed to: _____

Comments: Section, township, and range determined by projecting normal Kansas survey system over Fort Riley.

verification method: Latitude and longitude, KGS "LEO" conversion tool, and Ogden 1:24,000 topo. map

initials: DRL date: 11/9/2007

submitted by: Kansas Geological Survey, Data Resources Library, 1930 Constant Ave., Lawrence, KS 66047-3726
to: Kansas Dept of Health & Environment, Bureau of Water, 1000 SW Jackson, Suite 420, Topeka, KS 66612-1367.

WATER WELL PLUGGING RECORD Form WWC-5P KSA 82a-1212 ID NO. ★1915CF92-03

1 LOCATION OF WATER WELL: County: Riley	Fraction ¼ ¼ ¼	Section Number	Township Number	Range Number E/W

Distance and direction from nearest town or city street address of well if located within city?
Ft Riley, Camp Funston East of street A and North of RR tracks

2 WATER WELL OWNER: Directorate of Public Works
RR#, St. Address, Box #: Environmental Division Bldg 407 Pershin Ct.
City, State ZIP Code: Ft. Riley, KS 66442

Global Positioning Systems (decimal degrees, min. of 4 digits)
Latitude: 39° 05' 57.949"
Longitude: 96° 44' 28.349"
Elevation:
Datum: NAD 83
Data Collection Method: Hand held GPS

3 MARK WELL'S LOCATION WITH AN "X" IN SECTION BOX:

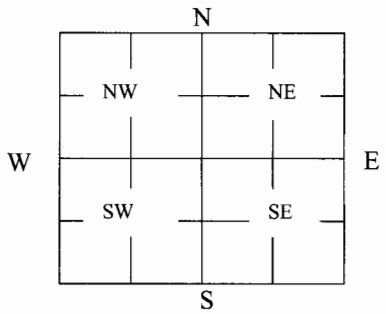

4 DEPTH OF WELL 49.4 ft.

WELL'S STATIC WATER LEVEL 29.2 ft

WELL WAS USED AS:

1 Domestic	5 Public Water Supply	9 Dewatering
2 Irrigation	6 Oil Field Water Supply	(10) Monitoring
3 Feedlot	7 Domestic (Lawn & Garden)	11 Injection Well
4 Industrial	8 Air Conditioning	12 Other

Was a chemical/bacteriological sample submitted to Department? Yes ____ No X

5 TYPE OF BLANK CASING USED:

1 Steel	3 RMP (SR)	5 Wrought	7 Fiberglass	9 Other (Specify below)
(2) PVC	4 ABS	6 Asbestos-Cement	8 Concrete Tile	

Blank casing diameter 2 in. Was casing pulled? Yes X No ____ If yes, how much 11.0 ft
Casing height above or (below) land surface 9.4 ~~in.~~ ft.

6 GROUT PLUG MATERIAL: (1) Neat cement 2 Cement grout 3 Bentonite 4 Other Clean Soil

Grout Plug Intervals: From 49.4 ft. to ~~Toc~~ 3.0 ft., From ____ ft. to ____ ft., From 3.0 to 0 ft.

What is the nearest source of possible contamination:

1 Septic tank	6 Seepage pit	11 Fuel Storage	(16) Other (specify below)
2 Sewer lines	7 Pit privy	12 Fertilizer storage	South Funston Land fill
3 Watertight sewer lines	8 Sewage lagoon	13 Insecticide storage	
4 Lateral lines	9 Feedyard	14 Abandoned water well	Direction from well? West and South
5 Cess pool	10 Livestock pens	15 Oil well/Gas well	How many feet? about 5000

FROM	TO	PLUGGING MATERIALS	FROM	TO	PLUGGING MATERIALS
49.4	3'	Neat Cement Grout			
3	0	Clean Soil			

7 CONTRACTOR'S OR LANDOWNER'S CERTIFICATION: This water well was plugged under my jurisdiction and was completed on (mo/day/year) 08/07/2007 and this record is true to the best of my knowledge and belief. Kansas Water Well Contractor's License No. N/A. This Water Well Record was completed on (mo/day/year) 08/10/2007 under the business name of US Army Corps of Engineers by (signature) Brenda Adams

INSTRUCTIONS: Use typewriter or ballpoint pen. Please press firmly and print clearly. Please fill in blanks, underline or circle the correct answers. Send top three copies to Kansas Department of Health and Environment, Bureau of Water, Geology Section, 1000 SW Jackson St., Ste. 420, Topeka, Kansas 66612-1367. Telephone: 785/296-5522. Send one to Water Well Owner and retain one for your records. Visit us at http://www.kdheks.gov/geo/waterwells.