

CORRECTION(S) TO WATER WELL RECORD (WWC-5)

(to rectify lacking or incorrect information)

Location listed as:

Section-Township-Range: None Given

Fraction ($\frac{1}{4}$ $\frac{1}{4}$ $\frac{1}{4}$): _____

County: Geary
Location changed to:

22-11S-6E

NE NE NE

Other changes: Initial statements: Riley County

Changed to: Geary County

Comments: Section, township, and range determined by projecting normal Kansas survey system over Fort Riley.

verification method: Latitude and longitude, KGS "LEO" conversion tool, and Ogden 1:24,000 topo. map

initials: ERL date: 11/9/2007


submitted by: Kansas Geological Survey, Data Resources Library, 1930 Constant Ave., Lawrence, KS 66047-3726

to: Kansas Dept of Health & Environment, Bureau of Water, 1000 SW Jackson, Suite 420, Topeka, KS 66612-1367.

1 LOCATION OF WATER WELL: County: <u>Riley</u>	Fraction $\frac{1}{4}$ $\frac{1}{4}$ $\frac{1}{4}$	Section Number	Township Number	Range Number E/W
----------------------------------------------------------	-------------------------------------------------------	----------------	-----------------	---------------------

Distance and direction from nearest town or city street address of well if located within city?
Ft. Riley, about 3/4 mile southeast of Williston Pt. Rd. and Huebner Rd. Intersection

2 WATER WELL OWNER: RR#, St. Address, Box #: <u>Directorate of Public Works Environmental Division Bldg 407 Pershing Ct. Ft. Riley KS 66442</u> City, State ZIP Code: <u>Ft. Riley KS 66442</u>	Global Positioning Systems (decimal degrees, min. of 4 digits) Latitude: <u>39° 05' 04.840"</u> Longitude: <u>96° 44' 09.462"</u> Elevation: _____ Datum: <u>NAD 83</u> Data Collection Method: <u>Hand held GPS</u>
---	---

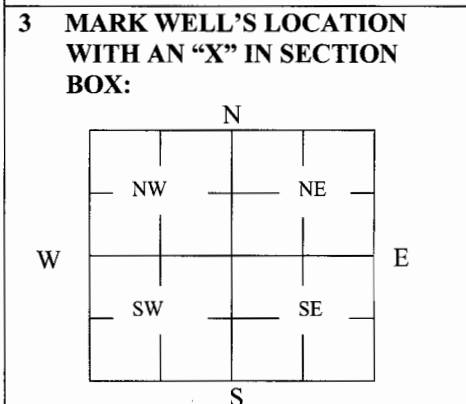

4 DEPTH OF WELL 41.6 ft. B6S

WELL'S STATIC WATER LEVEL 15 ft B6S

WELL WAS USED AS:

1 Domestic	5 Public Water Supply	9 Dewatering
2 Irrigation	6 Oil Field Water Supply	<input checked="" type="radio"/> 10 Monitoring
3 Feedlot	7 Domestic (Lawn & Garden)	11 Injection Well
4 Industrial	8 Air Conditioning	12 Other _____

Was a chemical/bacteriological sample submitted to Department? Yes _____ No

5 TYPE OF BLANK CASING USED:

1 Steel	3 RMP (SR)	5 Wrought	7 Fiberglass	9 Other (Specify below)
<input checked="" type="radio"/> 2 PVC	4 ABS	6 Asbestos-Cement	8 Concrete Tile	

Blank casing diameter 4.7 in. Was casing pulled? Yes No _____ If yes, how much 4.7

Casing height above or below land surface 3.2 ~~ft.~~

6 GROUT PLUG MATERIAL: 1 Neat cement 2 Cement grout 3 Bentonite 4 Other Clean Soil

Grout Plug Intervals: From 41.6 ft. to 3.2 ft., From _____ ft. to _____ ft., From 3.2 to 0 ft.

What is the nearest source of possible contamination:

1 Septic tank	6 Seepage pit	11 Fuel Storage	<input checked="" type="radio"/> 16 Other (specify below)
2 Sewer lines	7 Pit privy	12 Fertilizer storage	<u>South Funston Landfill</u>
3 Watertight sewer lines	8 Sewage lagoon	13 Insecticide storage	
4 Lateral lines	9 Feedyard	14 Abandoned water well	Direction from well? _____
5 Cess pool	10 Livestock pens	15 Oil well/Gas well	How many feet? _____

FROM	TO	PLUGGING MATERIALS	FROM	TO	PLUGGING MATERIALS
<u>41.6</u>	<u>3.2</u>	<u>Neat Cement Grout</u>			
<u>3.2</u>	<u>0</u>	<u>Clean soil</u>			

7 CONTRACTOR'S OR LANDOWNER'S CERTIFICATION: This water well was plugged under my jurisdiction and was completed on (mo/day/year) 08/08/2007 and this record is true to the best of my knowledge and belief. Kansas Water Well Contractor's License No. N/A. This Water Well Record was completed on (mo/day/year) 08/10/2007 under the business name of US Army Corps of Eng. nees by (signature) Brenda Adams

INSTRUCTIONS: Use typewriter or ballpoint pen. Please press firmly and print clearly. Please fill in blanks, underline or circle the correct answers. Send top three copies to Kansas Department of Health and Environment, Bureau of Water, Geology Section, 1000 SW Jackson St., Ste. 420, Topeka, Kansas 66612-1367. Telephone: 785/296-5522. Send one to Water Well Owner and retain one for your records. Visit us at <http://www.kdheks.gov/geo/waterwells>.