

CORRECTION(S) TO WATER WELL RECORD (WWC-5)

(to rectify lacking or incorrect information)

Location listed as:

Section-Township-Range: None Given

Fraction ($\frac{1}{4}$ $\frac{1}{4}$ $\frac{1}{4}$): _____

County: Riley

Location changed to:

23-11S-6E

NW SW SE NE NW

Other changes: Initial statements: _____

Changed to: _____

Comments: Section, township, and range determined by
projecting normal Kansas survey system over Fort Riley.

verification method: Latitude and longitude, KGS "LEO" conversion
tool, and Ogden 1:24,000 topo map

initials: DRD date: 11/9/2007

submitted by: Kansas Geological Survey, Data Resources Library, 1930 Constant Ave., Lawrence, KS 66047-3726
to: Kansas Dept of Health & Environment, Bureau of Water, 1000 SW Jackson, Suite 420, Topeka, KS 66612-1367.

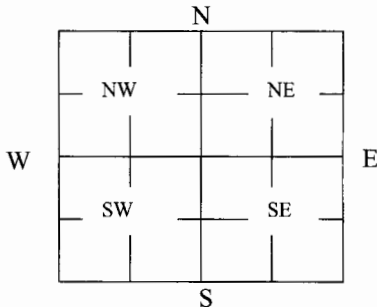
WATER WELL PLUGGING RECORD Form WWC-5P
KSA 82a-1212
ID NO.
MW 1

1 LOCATION OF WATER WELL: County: <u>Riley</u>	Fraction $\frac{1}{4}$ $\frac{1}{4}$ $\frac{1}{4}$	Section Number	Township Number	Range Number E/W
--	---	----------------	-----------------	---------------------

Distance and direction from nearest town or city street address of well if located within city?

Ft. Riley about 1 mi SE of Williston Pt. Rd and Hubner Rd Intersection

2 WATER WELL OWNER: RR#, St. Address, Box #: <u>Directorate of Public Works</u> <u>Environmental Division</u> <u>Blkg 407 Pershing Ct.</u> City, State ZIP Code: <u>Ft. Riley, KS 66442</u>	Global Positioning Systems (decimal degrees, min. of 4 digits) Latitude: <u>39° 05' 12.590"</u> Longitude: <u>96° 44' 39.832"</u> Elevation: _____ Datum: <u>NAD 83</u> Data Collection Method: <u>Handheld GPS</u>
--	---

3 MARK WELL'S LOCATION WITH AN "X" IN SECTION BOX:

4 DEPTH OF WELL 57.8 ft.

 WELL'S STATIC WATER LEVEL 12.7 ft

WELL WAS USED AS:

- | | | |
|--------------|----------------------------|--|
| 1 Domestic | 5 Public Water Supply | 9 Dewatering |
| 2 Irrigation | 6 Oil Field Water Supply | <input checked="" type="radio"/> 10 Monitoring |
| 3 Feedlot | 7 Domestic (Lawn & Garden) | 11 Injection Well |
| 4 Industrial | 8 Air Conditioning | 12 Other _____ |

 Was a chemical/bacteriological sample submitted to Department? Yes _____ No ☒
5 TYPE OF BLANK CASING USED:

- | | | | | |
|--|------------|-------------------|-----------------|-------------------------|
| 1 Steel | 3 RMP (SR) | 5 Wrought | 7 Fiberglass | 9 Other (Specify below) |
| <input checked="" type="radio"/> 2 PVC | 4 ABS | 6 Asbestos-Cement | 8 Concrete Tile | |

 Blank casing diameter 4 in. Was casing pulled? Yes ☒ No _____ If yes, how much 4.9
 Casing height above or below and surface 3.1 ft.

6 GROUT PLUG MATERIAL: ☒ 1 Neat cement 2 Cement grout 3 Bentonite 4 Other clean soil

 Grout Plug Intervals: From 57.8 ft. to 3.1 ft., From _____ ft. to _____ ft., From 3.1 to 0 ft.

What is the nearest source of possible contamination:

- | | | | |
|--------------------------|-------------------|-------------------------|---|
| 1 Septic tank | 6 Seepage pit | 11 Fuel Storage | <input checked="" type="radio"/> 16 Other (specify below) |
| 2 Sewer lines | 7 Pit privy | 12 Fertilizer storage | <u>South Funston Landf. II</u> |
| 3 Watertight sewer lines | 8 Sewage lagoon | 13 Insecticide storage | |
| 4 Lateral lines | 9 Feedyard | 14 Abandoned water well | Direction from well? _____ |
| 5 Cess pool | 10 Livestock pens | 15 Oil well/Gas well | How many feet? _____ |

FROM	TO	PLUGGING MATERIALS	FROM	TO	PLUGGING MATERIALS
57.8	3.1	Neat cement Grout			
3.1	0	Clean Soil			

7 CONTRACTOR'S OR LANDOWNER'S CERTIFICATION: This water well was plugged under my jurisdiction and was completed on (mo/day/year) 08/08/2007 and this record is true to the best of my knowledge and belief. Kansas Water Well Contractor's License No. N/A. This Water Well Record was completed on (mo/day/year) 08/10/07 under the business name of US Army Corps of Engineers by (signature) Brendan Plano

INSTRUCTIONS: Use typewriter or ballpoint pen. Please press firmly and print clearly. Please fill in blanks, underline or circle the correct answers. Send top three copies to Kansas Department of Health and Environment, Bureau of Water, Geology Section, 1000 SW Jackson St., Ste. 420, Topeka, Kansas 66612-1367. Telephone: 785/296-5522. Send one to Water Well Owner and retain one for your records. Visit us at <http://www.kdheks.gov/geo/waterwells>.