

CORRECTION(S) TO WATER WELL RECORD (WWC-5)

(to rectify lacking or incorrect information)

Location listed as:

County:

Riley

Location changed to:

Section-Township-Range:

None Given

15-11 S-6 E

Fraction ($\frac{1}{4}$ $\frac{1}{4}$ $\frac{1}{4}$):

S2 S2 N2 S2

Other changes: Initial statements:

Changed to:

Comments:

Section, township, and range determined by
projecting normal Kansas survey system over Fort Riley.

verification method:

Latitude and longitude, KGS "LEO" conversion
tool, and Junction City 1:24,000 topo. map

initials:

DRL

date:

11/9/2007

submitted by: Kansas Geological Survey, Data Resources Library, 1930 Constant Ave., Lawrence, KS 66047-3726

to: Kansas Dept of Health & Environment, Bureau of Water, 1000 SW Jackson, Suite 420, Topeka, KS 66612-1367.

WATER WELL PLUGGING RECORD Form WWC-5P

KSA 82a-1212

ID NO.

SFL 92-103


1 LOCATION OF WATER WELL: County: Riley Fraction $\frac{1}{4}$ $\frac{1}{4}$ $\frac{1}{4}$ Section Number Township Number Range Number E/W

Distance and direction from nearest town or city street address of well if located within city?
 Ft Riley, Camp Funston, North of Huebner Rd East of Wellhouse Rd

2 WATER WELL OWNER: Directorate of Public Works, Environmental Division
 RR#, St. Address, Box #: Bldg 407, Pershing Ct.
 City, State ZIP Code: Ft Riley, KS 66442

Global Positioning Systems (decimal degrees, min. of 4 digits)
 Latitude: 39° 51' 31.556" N
 Longitude: 96° 45' 9.577" W
 Elevation:
 Datum: NAD83
 Data Collection Method: hand held gps

3 MARK WELL'S LOCATION WITH AN "X" IN SECTION BOX:

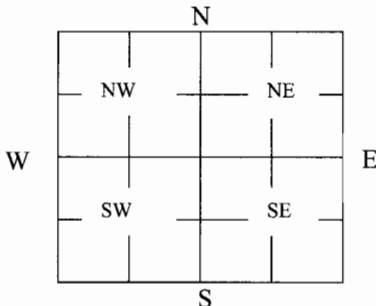

4 DEPTH OF WELL 64.25 ft.

WELL'S STATIC WATER LEVEL 34.6' ft

WELL WAS USED AS:

- | | | |
|--------------|----------------------------|--|
| 1 Domestic | 5 Public Water Supply | 9 Dewatering |
| 2 Irrigation | 6 Oil Field Water Supply | <input checked="" type="radio"/> 10 Monitoring |
| 3 Feedlot | 7 Domestic (Lawn & Garden) | 11 Injection Well |
| 4 Industrial | 8 Air Conditioning | 12 Other |

Was a chemical/bacteriological sample submitted to Department? Yes No ☒

5 TYPE OF BLANK CASING USED:

- | | | | | |
|--|------------|-------------------|-----------------|-------------------------|
| 1 Steel | 3 RMP (SR) | 5 Wrought | 7 Fiberglass | 9 Other (Specify below) |
| <input checked="" type="radio"/> 2 PVC | 4 ABS | 6 Asbestos-Cement | 8 Concrete Tile | |

Blank casing diameter 2 in. Was casing pulled? Yes ☒ No ☐ If yes, how much 5.3'
 Casing height above or below land surface 3.6 ft.

6 GROUT PLUG MATERIAL: ☒ 1 Neat cement 2 Cement grout 3 Bentonite 4 Other Top soil

Grout Plug Intervals: From 64.25 ft. to 3 ft., From _____ ft. to _____ ft., From 3 to 0 ft.

What is the nearest source of possible contamination:

- | | | | |
|--------------------------|-------------------|-------------------------|---|
| 1 Septic tank | 6 Seepage pit | 11 Fuel Storage | <input checked="" type="radio"/> 16 Other (specify below) |
| 2 Sewer lines | 7 Pit privy | 12 Fertilizer storage | <u>South Funston Landfill</u> |
| 3 Watertight sewer lines | 8 Sewage lagoon | 13 Insecticide storage | |
| 4 Lateral lines | 9 Feedyard | 14 Abandoned water well | Direction from well? <u>SE</u> |
| 5 Cess pool | 10 Livestock pens | 15 Oil well/Gas well | How many feet? <u>3100</u> |

FROM	TO	PLUGGING MATERIALS	FROM	TO	PLUGGING MATERIALS
<u>62.5</u>	<u>64.5</u>	<u>Neat cement grout</u>			
	<u>3.0'</u>	<u>top soil</u>			

7 CONTRACTOR'S OR LANDOWNER'S CERTIFICATION: This water well was plugged under my jurisdiction and was completed on (mo/day/year) 08/07/07 and this record is true to the best of my knowledge and belief. Kansas Water Well Contractor's License No. N/A. This Water Well Record was completed on (mo/day/year) 08/10/07 under the business name of US Army Corps of Engineers by (signature) Brenda Adams

INSTRUCTIONS: Use typewriter or ballpoint pen. Please press firmly and print clearly. Please fill in blanks, underline or circle the correct answers. Send top three copies to Kansas Department of Health and Environment, Bureau of Water, Geology Section, 1000 SW Jackson St., Ste. 420, Topeka, Kansas 66612-1367. Telephone: 785/296-5522. Send one to Water Well Owner and retain one for your records. Visit us at <http://www.kdheks.gov/geo/waterwells>.