

CORRECTION(S) TO WATER WELL RECORD (WWC-5)

(to rectify lacking or incorrect information)

County: Geary

Location listed as:

Location changed to:

Section-Township-Range: 27-11S-6E

27-11S-6E

Fraction (1/4 1/4 1/4): None Given

SW SW SW

Other changes: Initial statements: _____

Changed to: _____

Comments: _____

verification method: Original construction record for this well.

initials: DD date: 12/3/2007


submitted by: Kansas Geological Survey, Data Resources Library, 1930 Constant Ave., Lawrence, KS 66047-3726

to: Kansas Dept of Health & Environment, Bureau of Water, 1000 SW Jackson, Suite 420, Topeka, KS 66612-1367.

1	LOCATION OF WATER WELL:	Fraction	Section Number	Township Number	Range Number
County:	<u>GEARY</u>	$\frac{1}{4}$ $\frac{1}{4}$ $\frac{1}{4}$	<u>27</u>	<u>11S</u>	<u>6E</u> E/W

Distance and direction from nearest town or city street address of well if located within city?

2 WATER WELL OWNER: DIRECTORATE OF PUBLIC WORKS ENVIRONMENTAL DIVISION
 RR #, St. Address, Box #: 407 PERSHING COURT
 City, State, ZIP Code: FT. RILEY, KS 66442
 Board of Agriculture, Division of Water Resources
 Application Number:

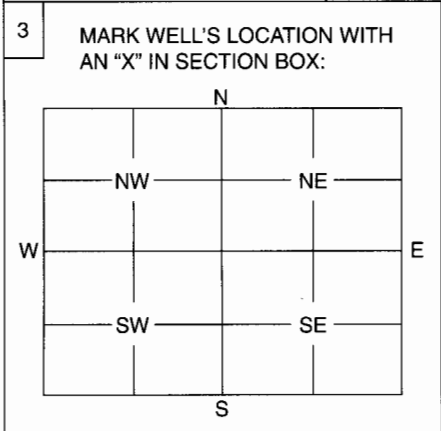

4 DEPTH OF WELL 71.1 ft.
 WELL'S STATIC WATER LEVEL 22.4 ft. FROM TOP CASING
 WELL WAS USED AS:
 1 Domestic 5 Public Water Supply 9 Dewatering
 2 Irrigation 6 Oil Field Water Supply 10 **Monitoring Well**
 3 Feedlot 7 Domestic (Lawn & Garden) 11 Injection Well
 4 Industrial 8 Air Conditioning 12 Other

Was a chemical / bacteriological sample submitted to Department? Yes No
 If yes, mo/day/yr sample was submitted

Water Well Disinfected: Yes No

5 TYPE OF BLANK CASING USED:
 1 Steel 3 RMP (SR) 5 Wrought 7 Fiberglass 9 Other (Specify below)
 2 **PVC** 4 ABS 6 Asbestos-Cement 8 Concrete Tile

Blank casing diameter in. Was casing pulled? Yes No If yes, how much 3'
 Casing height above or below 2 land surface 36" in.

6 GROUT PLUG MATERIAL: 1 Neat cement 2 Cement grout 3 Bentonite 4 Other CEMENT-BENTONITE GROUT
 Grout Plug Intervals: From 71 ft. to 4 ft., From ft. to ft., From to ft.

What is the nearest source of possible contamination:
 1 Septic tank 6 Seepage pit 11 Fuel storage 16 Other (specify below)
 2 Sewer lines 7 Pit privy 12 Fertilizer storage
 3 Watertight sewer lines 8 Sewage lagoon 13 Insecticide storage
 4 Lateral lines 9 Feedyard 14 Abandoned water well
 5 Cess pool 10 Livestock pens 15 Oil well/Gas well

Direction from well? How many feet?

FROM	TO	PLUGGING MATERIALS
<u>0</u>	<u>4</u>	<u>Native Soil</u>
<u>4</u>	<u>71</u>	<u>Cement Bentonite Grout</u>

7 CONTRACTOR'S OF LANDOWNER'S CERTIFICATION: This water well was plugged under my jurisdiction and was completed on (mo/day/year) 5/30/2007 and this record is true to the best of my knowledge and belief. Kansas Water Well Contractor's License No. 24 JULY 07 under the business name of USACE This Water Well Record was completed on (mo/day/year) by (signature) Robert Woods

INSTRUCTIONS: Use typewriter or ball point pen. Please press firmly and print clearly. Please fill in blanks, underline or circle the correct answers. Send top three copies to Kansas Department of Health and Environment, Bureau of Water, Geology Section, 1000 SW Jackson St., Ste. 420, Topeka, Kansas 66612-1367. Telephone: 785/296-5522. Send one to Water Well Owner and retain one for your records.