

CORRECTION(S) TO WATER WELL RECORD (WWC-5)
(to rectify lacking or incorrect information)

County: Geary

Location listed as:

Section-Township-Range: None

Fraction ($\frac{1}{4}$ $\frac{1}{4}$ $\frac{1}{4}$): _____

Location changed to:

21-T11-6E

SW NW NE

Other changes: Initial statements: _____

Changed to: _____

Comments: _____

verification method: LEO, USGS Topo map

initials: PT date: 12/14/09


submitted by: Kansas Geological Survey, Data Resources Library, 1930 Constant Ave., Lawrence, KS 66047-3726
to: Kansas Dept of Health & Environment, Bureau of Water, 1000 SW Jackson, Suite 420, Topeka, KS 66612-1367.

N 39 05 09.779
E 96 46 11.603

1	LOCATION OF WATER WELL:	Fraction	Section Number	Township Number	Range Number
County:		$\frac{1}{4}$ $\frac{1}{4}$ $\frac{1}{4}$			E/W

Distance and direction from nearest town or city street address of well if located within city?

2 WATER WELL OWNER: Public Works Environmental Division
 RR #, St. Address, Box #: 404 Pershing Pershing CT
 City, State, ZIP Code: Ft Riley, KS, 66442
 Board of Agriculture, Division of Water Resources
 Application Number:

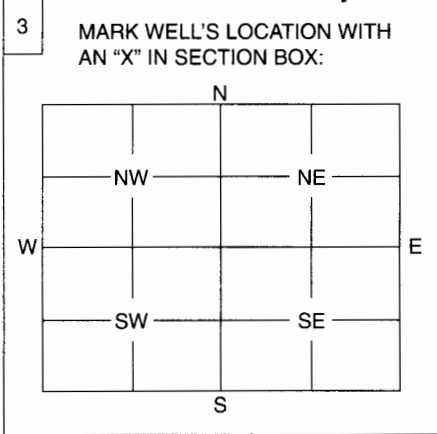

4 DEPTH OF WELL 56.92 ft. TOC
 WELL'S STATIC WATER LEVEL 47.02 ft. TOC
 WELL WAS USED AS:
 1 Domestic 5 Public Water Supply 9 Dewatering
 2 Irrigation 6 Oil Field Water Supply 10 Monitoring Well
 3 Feedlot 7 Domestic (Lawn & Garden) 11 Injection Well
 4 Industrial 8 Air Conditioning 12 Other

Was a chemical / bacteriological sample submitted to Department? Yes No X.....
 If yes, mo/day/yr sample was submitted

Water Well Disinfected: Yes No X.....

5 TYPE OF BLANK CASING USED:
 1 Steel 3 RMP (SR) 5 Wrought 7 Fiberglass 9 Other (Specify below)
 2 PVC 4 ABS 6 Asbestos-Cement 8 Concrete Tile

Blank casing diameter 4 in. Was casing pulled? Yes X No If yes, how much 3.0'
 Casing height above or below land surface +22 in.

6 GROUT PLUG MATERIAL: 1 Neat cement 2 Cement grout 3 Bentonite 4 Other Cement Bentonite Grout
 Grout Plug Intervals: From 3.0 ft. to 55.1 ft., From ft. to ft., From to ft.

What is the nearest source of possible contamination:
 1 Septic tank 6 Seepage pit 11 Fuel storage 16 Other (specify below)
 2 Sewer lines 7 Pit privy 12 Fertilizer storage

Direction from well? How many feet?

FROM	TO	PLUGGING MATERIALS
0	3	Native Material
3.0	55.1	Cement Bentonite Grout

7 CONTRACTOR'S OF LANDOWNER'S CERTIFICATION: This water well was plugged under my jurisdiction and was completed on (mo/day/year) 29 Sept 2009 and this record is true to the best of my knowledge and belief. Kansas Water Well Contractor's License No. 5 Oct 2009 This Water Well Record was completed on (mo/day/year) 5 Oct 2009 under the business name of USA CE by (signature) Arthur S Wood

INSTRUCTIONS: Use typewriter or ball point pen. Please press firmly and print clearly. Please fill in blanks, underline or circle the correct answers. Send top three copies to Kansas Department of Health and Environment, Bureau of Water, Geology Section, 1000 SW Jackson St., Ste. 420, Topeka, Kansas 66612-1367. Telephone: 785/296-5522. Send one to Water Well Owner and retain one for your records.