

## CORRECTION(S) TO WATER WELL RECORD (WWC-5)

(to rectify lacking or incorrect information)

County:

Riley

Location listed as:

Section-Township-Range:

None

Fraction (  $\frac{1}{4}$   $\frac{1}{4}$   $\frac{1}{4}$ ):

Location changed to:

13 - T11 - 6E

SW NW SE

Other changes: Initial statements:

Changed to:

Comments:

verification method:

LEO, USGS Topographic map

initials:

PT

date:

12/14/09

submitted by: Kansas Geological Survey, Data Resources Library, 1930 Constant Ave., Lawrence, KS 66047-3726

to: Kansas Dept of Health &amp; Environment, Bureau of Water, 1000 SW Jackson, Suite 420, Topeka, KS 66612-1367.

N 39 05 31.743

E 96 42 48.022

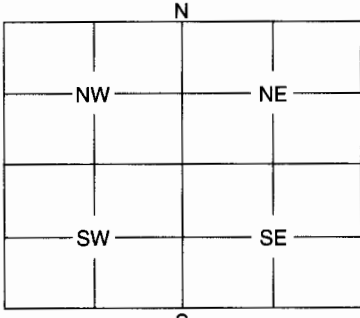
WATER WELL PLUGGING RECORD

Form WWC-5P

KSA 82a-1212

ID NO.

CF 90-06

1	LOCATION OF WATER WELL:	Fraction <div style="display: flex; justify-content: space-around;"><span>1/4</span><span>1/4</span><span>1/4</span></div>	Section Number	Township Number	Range Number																											
County: _____ E/W _____																																
Distance and direction from nearest town or city street address of well if located within city?																																
2	WATER WELL OWNER: <u>Public Works Environmental Division</u> RR #, St. Address, Box #: <u>404 Penning Court</u> City, State, ZIP Code: <u>Fort Riley, KS 66442</u>																															
Board of Agriculture, Division of Water Resources Application Number: _____																																
3	MARK WELL'S LOCATION WITH AN "X" IN SECTION BOX: <div style="text-align: center;">  </div>		4	DEPTH OF WELL ..... <u>38.3</u> ft. <u>TOC</u> WELL'S STATIC WATER LEVEL <u>23.9</u> ft. <u>TOC</u> WELL WAS USED AS: <div style="display: flex; justify-content: space-between;"> <div>           1 Domestic 2 Irrigation 3 Feedlot 4 Industrial         </div> <div>           5 Public Water Supply 6 Oil Field Water Supply 7 Domestic (Lawn &amp; Garden) 8 Air Conditioning         </div> <div>           9 Dewatering 10 Monitoring Well 11 Injection Well 12 Other .....         </div> </div>																												
Was a chemical / bacteriological sample submitted to Department? Yes ..... No <u>X</u> If yes, mo/day/yr sample was submitted ..... Water Well Disinfected: Yes ..... No <u>X</u>																																
5	TYPE OF BLANK CASING USED: <div style="display: flex; justify-content: space-between;"> <div>           1 Steel 2 <u>PVC</u> 3 RMP (SR) 4 ABS         </div> <div>           5 Wrought 6 Asbestos-Cement 7 Fiberglass 8 Concrete Tile         </div> <div>           9 Other (Specify below) .....         </div> </div>																															
Blank casing diameter <u>2</u> in. Was casing pulled? Yes <u>X</u> No ..... If yes, how much <u>3.0</u> Casing height above or below land surface <u>16</u> in.																																
6	GROUT PLUG MATERIAL: 1 Neat cement 2 Cement grout 3 Bentonite 4 Other <u>Cement Bentonite</u> Grout Plug Intervals: From <u>3.0</u> ft. to <u>37.0</u> ft., From ..... ft. to ..... ft., From ..... to ..... ft. What is the nearest source of possible contamination: <div style="display: flex; justify-content: space-between;"> <div>           1 Septic tank 2 Sewer lines 3 Watertight sewer lines 4 Lateral lines 5 Cess pool         </div> <div>           6 Seepage pit 7 Pit privy 8 Sewage lagoon 9 Feedyard 10 Livestock pens         </div> <div>           11 Fuel storage 12 Fertilizer storage 13 Insecticide storage 14 Abandoned water well 15 Oil well/Gas well         </div> <div>           16 Other (specify below) .....         </div> </div>																															
Direction from well? ..... How many feet? .....																																
<table border="1" style="width:100%; border-collapse: collapse;"> <thead> <tr> <th style="width:10%;">FROM</th> <th style="width:10%;">TO</th> <th style="width:80%;">PLUGGING MATERIALS</th> </tr> </thead> <tbody> <tr> <td style="text-align: center;">0</td> <td style="text-align: center;">3</td> <td><u>Native Material</u></td> </tr> <tr> <td style="text-align: center;">3</td> <td style="text-align: center;">37.0</td> <td><u>Cement Bentonite Grout</u></td> </tr> <tr><td> </td><td> </td><td> </td></tr> <tr><td> </td><td> </td><td> </td></tr> <tr><td> </td><td> </td><td> </td></tr> <tr><td> </td><td> </td><td> </td></tr> <tr><td> </td><td> </td><td> </td></tr> <tr><td> </td><td> </td><td> </td></tr> </tbody> </table>						FROM	TO	PLUGGING MATERIALS	0	3	<u>Native Material</u>	3	37.0	<u>Cement Bentonite Grout</u>																		
FROM	TO	PLUGGING MATERIALS																														
0	3	<u>Native Material</u>																														
3	37.0	<u>Cement Bentonite Grout</u>																														
7	CONTRACTOR'S OF LANDOWNER'S CERTIFICATION: This water well was plugged under my jurisdiction and was completed on (mo/day/year) <u>30 Sep 89</u> and this record is true to the best of my knowledge and belief. Kansas Water Well Contractor's License No. .... This Water Well Record was completed on (mo/day/year) <u>6 Oct 89</u> under the business name of <u>US Army Corps of Engineers</u> by (signature) <u>[Signature]</u>																															
INSTRUCTIONS: Use typewriter or ball point pen. Please press firmly and print clearly. Please fill in blanks, underline or circle the correct answers. Send top three copies to Kansas Department of Health and Environment, Bureau of Water, Geology Section, 1000 SW Jackson St., Ste. 420, Topeka, Kansas 66612-1367. Telephone: 785/296-5522. Send one to Water Well Owner and retain one for your records.																																