

CORRECTION(S) TO WATER WELL RECORD (WWC-5)

(to rectify lacking or incorrect information)

County: Riley

Location listed as:

Location changed to:

Section-Township-Range: 14-115-6E

14-115-6E

Fraction ($\frac{1}{4}$ $\frac{1}{4}$ $\frac{1}{4}$): SE SE SW

SE SW SE SW

Other changes: Initial statements: Geary County

Changed to: Riley County

Comments: Section, township, and range determined by projecting regular Kansas survey system over Fort Riley.

verification method: Latitude & Longitude & KGS' "LEO" conversion tool, written & legal descriptions, area road map, and mapping tool on KGS website. initials: ARL date: 4/25/2011

submitted by: Kansas Geological Survey, Data Resources Library, 1930 Constant Ave., Lawrence, KS 66047-3726

to: Kansas Dept of Health & Environment, Bureau of Water, 1000 SW Jackson, Suite 420, Topeka, KS 66612-1367.

WATER WELL PLUGGING RECORD Form WWC-5P

KSA 82a-1212

ID NO.

SFL 94-3B

1 LOCATION OF WATER WELL:

County: Geary

Fraction

SE 1/4 SE 1/4 SW 1/4

Section Number

14

Township Number

11S

Range Number

6 EDistance and direction from nearest town or city street address of well if located within city? Approximately 700' SW of 10th St & A St Camp Funston, Ft. Riley, K.S.

2 WATER WELL OWNER:

Public Works Environmental Division

RR#, St. Address, Box #:

404 Pershing St.

City, State ZIP Code:

Ft. Riley KS 66442

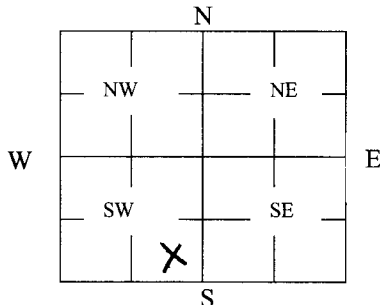
Global Positioning Systems (decimal degrees, min. of 4 digits)

Latitude: 39.08851423Longitude: 96.7371668

Elevation:

Datum: NAD83Data Collection Method: Hand held GPS

3 MARK WELL'S LOCATION WITH AN "X" IN SECTION BOX:

4 DEPTH OF WELL 63.7 ft.WELL'S STATIC WATER LEVEL 12.9 ft

WELL WAS USED AS:

- 1 Domestic
2 Irrigation
3 Feedlot
4 Industrial

- 5 Public Water Supply
6 Oil Field Water Supply
7 Domestic (Lawn & Garden)
8 Air Conditioning

- 9 Dewatering
10 Monitoring
11 Injection Well
12 Other _____

Was a chemical/bacteriological sample submitted to Department? Yes _____ No _____

5 TYPE OF BLANK CASING USED:

1 Steel

3 RMP (SR)

5 Wrought

7 Fiberglass

9 Other (Specify below) _____

2 PVC

4 ABS

6 Asbestos-Cement

8 Concrete Tile

Blank casing diameter 2 in. Was casing pulled? Yes ☒ No _____ If yes, how much 4.7'Casing height above or below land surface 36 in.6 GROUT PLUG MATERIAL: 1 Neat cement 2 Cement grout 3 Bentonite 4 Other _____Grout Plug Intervals: From 62 ft. to 3 ft., From _____ ft. to _____ ft., From _____ to _____ ft.

What is the nearest source of possible contamination:

1 Septic tank

6 Seepage pit

11 Fuel Storage

16 Other (specify below) _____

2 Sewer lines

7 Pit privy

12 Fertilizer storage

3 Watertight sewer lines

8 Sewage lagoon

13 Insecticide storage

4 Lateral lines

9 Feedyard

14 Abandoned water well

Direction from well? _____

5 Cess pool

10 Livestock pens

15 Oil well/Gas well

How many feet? _____

FROM	TO	PLUGGING MATERIALS	FROM	TO	PLUGGING MATERIALS
<u>62'</u>	<u>3'</u>	<u>Neat cement grout</u>			
<u>3'</u>	<u>0'</u>	<u>Native Soil</u>			

Original Returned to Sender
for Correction Date: 12/22/10

7 CONTRACTOR'S OR LANDOWNER'S CERTIFICATION: This water well was plugged under my jurisdiction and was completed on (mo/day/year) 10/14/10 and this record is true to the best of my knowledge and belief. Kansas Water Well Contractor's License No. _____. This Water Well Record was completed on (mo/day/year) 11/14/10 under the business name of USACE by (signature) [Signature]

INSTRUCTIONS: Use typewriter or ballpoint pen. Please press firmly and print clearly. Please fill in blanks, underline or circle the correct answers. Send top three copies to Kansas Department of Health and Environment, Bureau of Water, Geology Section, 1000 SW Jackson St., Ste. 420, Topeka, Kansas 66612-1367. Telephone: 785/296-5522. Send one to Water Well Owner and retain one for your records. Visit us at <http://www.kdheks.gov/geo/waterwells>.