

CORRECTION(S) TO WATER WELL RECORD (WWC-5)

(to rectify lacking or incorrect information)

County: Riley

Location listed as:

Section-Township-Range: 14-11S-6E

Fraction ($\frac{1}{4}$ $\frac{1}{4}$ $\frac{1}{4}$): SE SW NW

Location changed to:

14-11S-6E

NE SW SW NW

Other changes: Initial statements: _____

Changed to: _____

Comments: Section, township, and range determined by projecting regular Kansas survey system over Fort Riley.

verification method: Latitude & Longitude & KGS' "LEO" conversion tool, written & legal descriptions, area road map, and mapping tool on KGS website. initials: ARL date: 4/25/2011

submitted by: Kansas Geological Survey, Data Resources Library, 1930 Constant Ave., Lawrence, KS 66047-3726

to: Kansas Dept of Health & Environment, Bureau of Water, 1000 SW Jackson, Suite 420, Topeka, KS 66612-1367.

WATER WELL PLUGGING RECORD Form WWC-5P

KSA 82a-1212

ID NO.

SEF-94-5B

1 LOCATION OF WATER WELL:

County: Riley

Fraction

SE 1/4 SW 1/4 NW 1/4

Section Number

14

Township Number

11S

Range Number

60WDistance and direction from nearest town or city street address of well if located within city? Approximately 700' west of A St & 4th St, Camp Funston, Ft. Riley, KS

2 WATER WELL OWNER:

Public Works Environmental Div.

RR#, St. Address, Box #:

404 Pershing Ct.

City, State ZIP Code:

Ft Riley KS 66442

Global Positioning Systems (decimal degrees, min. of 4 digits)

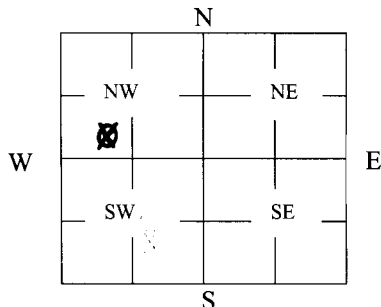
Latitude: 39°05'45.796"NLongitude: 96°44'30.543"W

Elevation: _____

Datum: _____

Data Collection Method: Handheld GPS

3 MARK WELL'S LOCATION WITH AN "X" IN SECTION BOX:

4 DEPTH OF WELL 60.5 ft.WELL'S STATIC WATER LEVEL 17.1 ft

WELL WAS USED AS:

1 Domestic

2 Irrigation

3 Feedlot

4 Industrial

5 Public Water Supply

6 Oil Field Water Supply

7 Domestic (Lawn & Garden)

8 Air Conditioning

9 Dewatering

10 Monitoring

11 Injection Well

12 Other _____

Was a chemical/bacteriological sample submitted to Department? Yes _____ No ☒

5 TYPE OF BLANK CASING USED:

1 Steel

3 RMP (SR)

5 Wrought

7 Fiberglass

9 Other (Specify below) _____

2 PVC

4 ABS

6 Asbestos-Cement

8 Concrete Tile

Blank casing diameter 2 in. Was casing pulled? Yes ☒ No _____ If yes, how much 4.0'Casing height above or below land surface 2 in. ft

6 GROUT PLUG MATERIAL:

1 Neat cement

2 Cement grout

3 Bentonite

4 Other Native Material

Grout Plug Intervals: From _____ ft. to _____ ft., From _____ ft. to _____ ft., From _____ to _____ ft.

What is the nearest source of possible contamination:

1 Septic tank

6 Seepage pit

11 Fuel Storage

16 Other (specify below) _____

2 Sewer lines

7 Pit privy

12 Fertilizer storage

3 Watertight sewer lines

8 Sewage lagoon

13 Insecticide storage

4 Lateral lines

9 Feedyard

14 Abandoned water well

Direction from well? _____

5 Cess pool

10 Livestock pens

15 Oil well/Gas well

How many feet? _____

FROM	TO	PLUGGING MATERIALS	FROM	TO	PLUGGING MATERIALS
0	3	<u>Native Material</u>			
3	60.5	<u>Bentonite cement grout</u>			

Original Returned to Sender

for Correction Date: 12/22/10

7 CONTRACTOR'S OR LANDOWNER'S CERTIFICATION:

This water well was plugged under my jurisdiction and was completed on (mo/day/year) 11/05/2009 and this record is true to the best of my knowledge and belief. Kansas Water

Well Contractor's License No. _____

This Water Well Record was completed on (mo/day/year) 11/05/2009 under thebusiness name of U.S. Army Corps of Engineersby (signature) [Signature]

INSTRUCTIONS: Use typewriter or ballpoint pen. Please press firmly and print clearly. Please fill in blanks, underline or circle the correct answers. Send top three copies to Kansas Department of Health and Environment, Bureau of Water, Geology Section, 1000 SW Jackson St., Ste. 420, Topeka, Kansas 66612-1367. Telephone: 785/296-5522. Send one to Water Well Owner and retain one for your records. Visit us at <http://www.kdheks.gov/geo/waterwells>.