

1 LOCATION OF WATER WELL: County: Riley	Fraction * See Below NW 1/4 NW 1/4 1/4	Section Number 13	Township Number T 11 S	Range Number R 6 EW
---	--	-----------------------------	----------------------------------	--------------------------------------

Distance and direction from nearest town or city street address of well if located within city?

Former Building 1245, Camp Funston, Fort Riley, KS

BLDG 1245 PZ15-7

2 WATER WELL OWNER: US Army Corps of Engineers

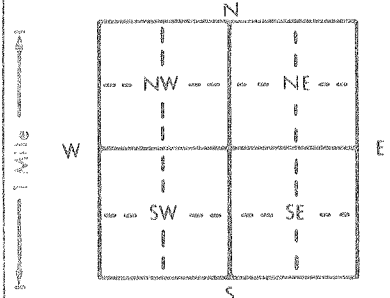
RR#, St. Address, Box # : 601 East 12th Street

Board of Agriculture, Division of Water Resources

City, State, ZIP Code : Kansas City, MO 64106

Application Number:

3 LOCATE WELL'S LOCATION WITH AN "X" IN SECTION BOX:

4 DEPTH OF COMPLETED WELL: **20** ft. ELEVATION: **1048.45271**

Depth(s) Groundwater Encountered 1. ft. 2. ft. 3. ft.

WELL'S STATIC WATER LEVEL **16.86** ft. below land surface measured on mo/day/yr **5/10/95**Pump test data: Well water was **17.41** ft. after hours pumping **4/21/97** gpm

Est. Yield gpm: Well water was ft. after hours pumping gpm

Bore Hole Diameter **1** in. to **20** ft. and in. to ft.

WELL WATER TO BE USED AS: 5 Public water supply 8 Air conditioning 11 Injection well

1 Domestic 3 Feedlot 6 Oil field water supply 9 Dewatering **12 Other (Specify below)**2 Irrigation 4 Industrial 7 Lawn and garden only 10 Monitoring well **Piezometer**Was a chemical/bacteriological sample submitted to Department? Yes.....No...**X**....; If yes, mo/day/yr sample was submitted

Water Well Disinfected? Yes No

5 TYPE OF BLANK CASING USED:

5 Wrought iron

8 Concrete tile

CASING JOINTS: Glued Clamped

1 Steel

3 RMP (SR)

6 Asbestos-Cement

9 Other (specify below)

Welded

2 PVC

4 ABS

7 Fiberglass

Threaded... **X**Blank casing diameter **1** in. to **14** ft. Dia. in. to ft. Dia. in. to ft.Casing height above land surface. in., weight **flush mount cover** lbs./ft. Wall thickness or gauge No **Schedule 40**

TYPE OF SCREEN OR PERFORATION MATERIAL:

1 Steel

3 Stainless steel

5 Fiberglass

7 PVC

10 Asbestos-cement

2 Brass

4 Galvanized steel

6 Concrete tile

8 RMP (SR)

11 Other (specify)

3 Mill slot

4 Key punched

5 Gauzed wrapped

6 Wire wrapped

8 Saw cut

11 None (open hole)

1 Continuous slot

2 Louvered shutter

7 Torch cut

9 Drilled holes

10 Other (specify)

SCREEN OR PERFORATION OPENINGS ARE:

SCREEN-PERFORATED INTERVALS: From **14** ft. to **20** ft. From ft. to ft.

GRAVEL PACK INTERVALS: From ft. to ft. From ft. to ft.

From ft. to ft. From ft. to ft.

From ft. to ft. From ft. to ft.

7 CONTRACTOR'S OR LANDOWNER'S CERTIFICATION: This water well was (1) constructed, (2) reconstructed, or (3) plugged under my jurisdiction and was completed on (mo/day/year) **4/21/97** and this record is true to the best of my knowledge and belief. KansasWater Well Contractor's License No. **606** This Water Well Record was completed on (mo/day/yr) **4/22/97**under the business name of **PSA Environmental** by (signature) **Ron K. Shaw**

INSTRUCTIONS: Use typewriter or ball point pen. PLEASE PRESS FIRMLY and PRINT clearly. Please fill in blanks, underline or circle the correct answers. Send top three copies to Kansas Department of Health and Environment, Bureau of Water, Topeka, Kansas 66620-0001. Telephone: 913-296-5545. Send one to WATER WELL OWNER and retain one for your records.

RECEIVED

MAY 22 1997

BUREAU OF WATER

DFT