

1 LOCATION OF WATER WELL:	Fraction *See Below	Section Number	Township Number	Range Number
County: Riley	SE $\frac{1}{4}$ NW $\frac{1}{4}$ $\frac{1}{4}$	13	T 11 S	R 6 EW

Distance and direction from nearest town or city street address of well if located within city?

Former Building 1637, Camp Funston, Fort Riley, KS

BLDG1637 PZ(2,15)

2 WATER WELL OWNER: US Army Corps of Engineers

RR#, St. Address, Box #: 601 East 12th Street


Board of Agriculture, Division of Water Resource

City, State, ZIP Code: Kansas City, MO 64106

Application Number:

3 LOCATE WELL'S LOCATION WITH AN "X" IN SECTION BOX:

4 DEPTH OF COMPLETED WELL 17 ft. ELEVATION: 1046.02107

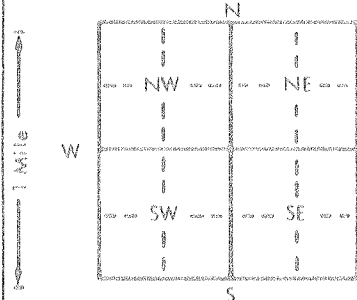

Depth(s) Groundwater Encountered 1. ft. 2. ft. 3. ft.

WELL'S STATIC WATER LEVEL 14.76 ft. below land surface measured on mo/day/yr 5/10/95

Pump test data: Well water was 14.76 ft. after 4/21/97 hours pumping gpm

Est. Yield gpm: Well water was 17 ft. after hours pumping gpm

Bore Hole Diameter 1 in. to 17 ft. and in. to ft.

WELL WATER TO BE USED AS: 5 Public water supply 8 Air conditioning 11 Injection well

1 Domestic 3 Feedlot 6 Oil field water supply 9 Dewatering 12 Other (Specify below)

2 Irrigation 4 Industrial 7 Lawn and garden only 10 Monitoring well Piezometer

Was a chemical/bacteriological sample submitted to Department? Yes.....No...X..... If yes, mo/day/yr sample was submitted

Water Well Disinfected? Yes No

5 TYPE OF BLANK CASING USED:

5 Wrought iron

8 Concrete tile

CASING JOINTS: Glued Clamped

1 Steel

3 RMP (SR)

6 Asbestos-Cement

9 Other (specify below)

Welded

2 PVC

4 ABS

7 Fiberglass

Threaded X

Blank casing diameter 1 in. to 11 ft. Dia in. to ft. Dia in. to ft.

Casing height above land surface in. weight flush mount cover lbs./ft. Wall thickness or gauge No. Schedule 40

TYPE OF SCREEN OR PERFORATION MATERIAL:

1 Steel

3 Stainless steel

5 Fiberglass

7 PVC

10 Asbestos-cement

2 Brass

4 Galvanized steel

6 Concrete tile

8 RMP (SR)

11 Other (specify)

1 Continuous slot

3 Mill slot

6 Wire wrapped

9 ABS

12 None used (open hole)

2 Louvered shutter

4 Key punched

7 Torch cut

10 Other (specify)

11 None (open hole)

SCREEN OR PERFORATION OPENINGS ARE:

1 Continuous slot

3 Mill slot

6 Wire wrapped

7 Torch cut

10 Other (specify)

2 Louvered shutter

4 Key punched

7 Torch cut

10 Other (specify)

11 None (open hole)

SCREEN-PERFORATED INTERVALS: From 11 ft. to 17 ft. From ft. to ft. From ft. to ft. From ft. to ft.

GRAVEL PACK INTERVALS: From ft. to ft. From ft. to ft. From ft. to ft. From ft. to ft.

6 GROUT MATERIAL:

1 Neat cement

2 Cement grout

3 Bentonite

4 Other

Grout Intervals: From 2 ft. to 1 ft. From ft. to ft. From ft. to ft. From ft. to ft.

What is the nearest source of possible contamination:

1 Septic tank

4 Lateral lines

7 Pit privy

10 Livestock pens

14 Abandoned water well

2 Sewer lines

5 Cess pool

8 Sewage lagoon

11 Fuel storage

15 Oil well/Gas well

3 Watertight sewer lines

6 Seepage pit

9 Feedyard

12 Fertilizer storage

16 Other (specify below)

13 Insecticide storage

UST Site

Direction from well?

How many feet?

FROM	TO	LITHOLOGIC LOG	FROM	TO	PLUGGING INTERVALS
0	17	Direct push without soil coring	3	17	Bentonite
			0	3	Surface soil
		*Location referenced to Ft. Riley Datum			
		280998.63281 N			
		2363580.13129 E			
		1046.02107 Elev.			

7 CONTRACTOR'S OR LANDOWNER'S CERTIFICATION: This water well was (1) constructed, (2) reconstructed, or (3) plugged under my jurisdiction and was completed on (mo/day/year) 4/21/97 and this record is true to the best of my knowledge and belief. Kansas

Water Well Contractor's License No. 606 This Water Well Record was completed on (mo/day/yr) 4/22/97

under the business name of PSA Environmental

by (signature)