

1 LOCATION OF WATER WELL: County: <b>Riley</b>	Fraction <b>*See Below</b> <b>SE 1/4 NW 1/4 1/4</b>	Section Number <b>14</b>	Township Number <b>T 11 S</b>	Range Number <b>R 6</b> <b>(EW)</b>
---	--	-----------------------------	----------------------------------	--

Distance and direction from nearest town or city street address of well if located within city?

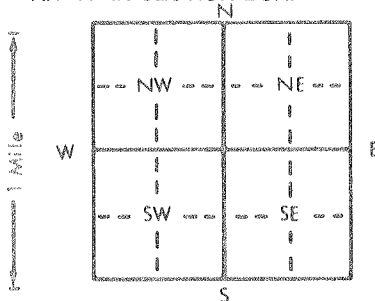
**Former Building 1044, Camp Funston, Fort Riley, KS****BLDG 1044 PZ(7,9)**2 WATER WELL OWNER: **US Army Corps of Engineers**RR#, St. Address, Box # : **601 East 12th Street**

Board of Agriculture, Division of Water Resources

City, State, ZIP Code : **Kansas City, MO 64106**

Application Number:

3 LOCATE WELL'S LOCATION WITH AN "X" IN SECTION BOX:

4 DEPTH OF COMPLETED WELL: **30** ft. ELEVATION: **1055.78**

Depth(s) Groundwater Encountered 1. .... ft. 2. .... ft. 3. .... ft.

WELL'S STATIC WATER LEVEL **22.40** ft. below land surface measured on mo/day/yr **9/22/94**Pump test data: Well water was **22.76** ft. after .... hours pumping **4/21/97** gpm

Est. Yield .... gpm: Well water was .... ft. after .... hours pumping .... gpm

Bore Hole Diameter: **1** in. to **30** ft., and .... in. to .... ft.

WELL WATER TO BE USED AS: 5 Public water supply 8 Air conditioning 11 Injection well

1 Domestic 3 Feedlot 6 Oil field water supply 9 Dewatering **12 Other (Specify below)**2 Irrigation 4 Industrial 7 Lawn and garden only 10 Monitoring well **Piezometer**Was a chemical/bacteriological sample submitted to Department? Yes.....No...**X**.....; If yes, mo/day/yr sample was submitted

Water Well Disinfected? Yes No

5 TYPE OF BLANK CASING USED:

- 1 Steel  
**2 PVC**  
 3 RMP (SR)  
 4 ABS

- 5 Wrought iron  
 6 Asbestos-Cement  
 7 Fiberglass  
 8 Concrete tile  
 9 Other (specify below)

CASING JOINTS: Glued .... Clamped ....

Welded ....

Threaded... **X** .....Blank casing diameter .. **1** in. to **24** ft., Dia .... in. to .... ft., Dia .... in. to .... ft.Casing height above land surface .... in., weight **flush mount cover** lbs./ft. Wall thickness or gauge No **Schedule 40**

TYPE OF SCREEN OR PERFORATION MATERIAL:

- 1 Steel  
 2 Brass  
 3 Stainless steel  
 4 Galvanized steel

- 5 Fiberglass  
 6 Concrete tile

**7 PVC**

- 8 RMP (SR)  
 9 ABS

10 Asbestos-cement

11 Other (specify) .....

12 None used (open hole)

SCREEN OR PERFORATION OPENINGS ARE:

- 1 Continuous slot  
 2 Louvered shutter  
**3 Mill slot**  
 4 Key punched

- 5 Gauzed wrapped  
 6 Wire wrapped  
 7 Torch cut

8 Saw cut

9 Drilled holes

10 Other (specify) .....

11 None (open hole)

SCREEN-PERFORATED INTERVALS: From **24** ft. to **30** ft., From .... ft. to .... ft.

From .... ft. to .... ft., From .... ft. to .... ft.

GRAVEL PACK INTERVALS: From .... ft. to .... ft., From .... ft. to .... ft.

From .... ft. to .... ft., From .... ft. to .... ft.

6 GROUT MATERIAL:

1 Neat cement

2 Cement grout

**3 Bentonite**

4 Other .....

Grout Intervals: From **2** ft. to **1** ft., From .... ft. to .... ft., From .... ft. to .... ft.

What is the nearest source of possible contamination:

- 1 Septic tank  
 2 Sewer lines  
 3 Watertight sewer lines  
 4 Lateral lines  
 5 Cess pool  
 6 Seepage pit

- 7 Pit privy  
 8 Sewage lagoon  
 9 Feedyard

10 Livestock pens

11 Fuel storage

12 Fertilizer storage

13 Insecticide storage

14 Abandoned water well

15 Oil well/Gas well

**16 Other (specify below)****UST Site**

Direction from well?

How many feet?

FROM	TO	LITHOLOGIC LOG	FROM	TO	PLUGGING INTERVALS
0	30	Direct push without soil coring	3	30	Bentonite
			0	3	Surface soil
		*Location referenced to Ft. Riley Datum			
		280789.72 N			
		2358305.37 E			
		1055.78 Elev.			

7 CONTRACTOR'S OR LANDOWNER'S CERTIFICATION: This water well was (1) constructed, (2) reconstructed, or **(3)** plugged under my jurisdiction and was completed on (mo/day/year) **4/21/97** and this record is true to the best of my knowledge and belief. KansasWater Well Contractor's License No. **506** This Water Well Record was completed on (mo/day/yr) **4/22/97**under the business name of **PSA Environmental**by (signature) *[Signature]*

071