

1 LOCATION OF WATER WELL:	Fraction *See Below	Section Number	Township Number	Range Number
County: Riley	NE $\frac{1}{4}$ SW $\frac{1}{4}$ $\frac{1}{4}$	14	T 11 S	R 6 E/W

Distance and direction from nearest town or city street address of well if located within city?

Former Building 1890, Camp Funston, Fort Riley, KS

BLDG 1890 PZ(2,7)

2 WATER WELL OWNER: US Army Corps of Engineers


RR#, St. Address, Box #: 601 East 12th Street

Board of Agriculture, Division of Water Resources

City, State, ZIP Code: Kansas City, MO 64106

Application Number:

3 LOCATE WELL'S LOCATION WITH AN "X" IN SECTION BOX:

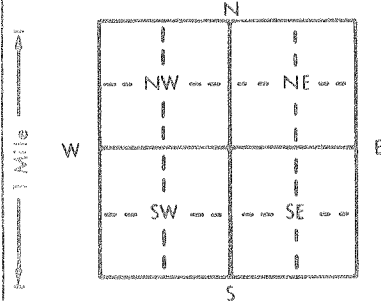

4 DEPTH OF COMPLETED WELL: 1050.96 ft. ELEVATION:

Depth(s) Groundwater Encountered 1. ft. 2. ft. 3. ft.

WELL'S STATIC WATER LEVEL 18.63 ft. below land surface measured on mo/day/yr 5/9/95

Pump test data: Well water was ft. after hours pumping gpm

Est. Yield gpm: Well water was ft. after hours pumping gpm

Bore Hole Diameter 1 in. to 21 ft. and in. to ft.

WELL WATER TO BE USED AS: 5 Public water supply 8 Air conditioning 11 Injection well

1 Domestic 3 Feedlot 6 Oil field water supply 9 Dewatering 12 Other (Specify below)

2 Irrigation 4 Industrial 7 Lawn and garden only 10 Monitoring well Piezometer

Was a chemical/bacteriological sample submitted to Department? Yes No X; If yes, mo/day/yr sample was submitted

Water Well Disinfected? Yes No

5 TYPE OF BLANK CASING USED:

1 Steel 3 RMP (SR)

2 PVC 4 ABS

Blank casing diameter 1 in. to 15 ft. Dia in. to ft. Dia in. to ft.

Casing height above land surface in. weight flush mount cover lbs./ft. Wall thickness or gauge No Schedule 40

TYPE OF SCREEN OR PERFORATION MATERIAL:

1 Steel 3 Stainless steel

2 Brass 4 Galvanized steel

5 Fiberglass

6 Concrete tile

7 PVC

8 RMP (SR)

9 ABS

10 Asbestos-cement

11 Other (specify)

12 None used (open hole)

SCREEN OR PERFORATION OPENINGS ARE:

1 Continuous slot

2 Louvered shutter

3 Mill slot

4 Key punched

5 Gauzed wrapped

6 Wire wrapped

7 Torch cut

8 Saw cut

9 Drilled holes

10 Other (specify)

11 None (open hole)

SCREEN-PERFORATED INTERVALS: From 15 ft. to 21 ft. From ft. to ft. From ft. to ft. From ft. to ft.

GRAVEL PACK INTERVALS: From ft. to ft. From ft. to ft. From ft. to ft. From ft. to ft.

6 GROUT MATERIAL:

1 Neat cement

2 Cement grout

3 Bentonite

4 Other

Grout Intervals: From 2 ft. to 1 ft. From ft. to ft. From ft. to ft. From ft. to ft.

What is the nearest source of possible contamination:

1 Septic tank

4 Lateral lines

7 Pit privy

10 Livestock pens

14 Abandoned water well

2 Sewer lines

5 Cess pool

8 Sewage lagoon

11 Fuel storage

15 Oil well/Gas well

3 Watertight sewer lines

6 Seepage pit

9 Feedyard

12 Fertilizer storage

16 Other (specify below)

13 Insecticide storage

UST Site

Direction from well?

How many feet?

FROM	TO	LITHOLOGIC LOG	FROM	TO	PLUGGING INTERVALS
0	21	Direct push without soil coring	3	3	Bentonite
		*Location referenced to Ft. Riley Datum	0	3	Surface soil
		278706.78834 N			UNABLE TO LOCATE PIEZOMETER.
		2359164.22870 E			Ft. Riley CONSTRUCTION
		1050.96 Elev.			ACTIVITIES HAVE APPARENTLY DESTROYED SURFACE COMPLETION.
					COMPACTED FILL EXISTS WITH A DEPTH OF AT LEAST TWO FEET BELOW GROUND SURFACE IN THE PIEZOMETER AREA.

7 CONTRACTOR'S OR LANDOWNER'S CERTIFICATION: This water well was (1) constructed, (2) reconstructed, or (3) plugged under my jurisdiction and was completed on (mo/day/year) 9/2/94 - Constructed and this record is true to the best of my knowledge and belief. Kansas Water Well Contractor's License No. 606 This Water Well Record was completed on (mo/day/yr) 4/22/97 under the business name of PSA Environmental by (signature)