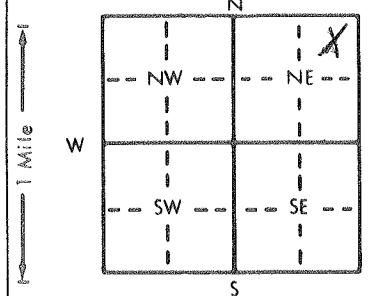


1 LOCATION OF WATER WELL: County: <u>Riley</u>	Fraction <u>NE 1/4 NE 1/4 NE 1/4</u>	Section Number <u>1</u>	Township Number <u>T 11 S</u>	Range Number <u>R 7 E</u>
---	---	----------------------------	----------------------------------	------------------------------

Distance and direction from nearest town or city street address of well if located within city? From Manhattan Co South on Medowville Road 5 miles To Ashland bottoms Rd 60 2.5 miles North + 2 miles East

2 WATER WELL OWNER: <u>Charles Roberts</u> RR#, St. Address, Box # : <u>1680 S. 20th St.</u> City, State, ZIP Code : <u>Manhattan, Kansas 66502</u>	<u>Riley Co Permit # 94230</u> Board of Agriculture, Division of Water Resource Application Number:
---	---

3 LOCATE WELL'S LOCATION WITH AN "X" IN SECTION BOX: 	4 DEPTH OF COMPLETED WELL: <u>40</u> ft. ELEVATION: Depth(s) Groundwater Encountered 1. <u>17</u> ft. 2. ft. 3. ft. WELL'S STATIC WATER LEVEL: <u>17</u> ft. below land surface measured on mo/day/yr Pump test data: Well water was ft. after hours pumping gpm Est. Yield <u>50</u> gpm: Well water was ft. after hours pumping gpm Bore Hole Diameter: <u>10</u> in. to <u>40</u> ft., and in. to ft. WELL WATER TO BE USED AS: 1 Domestic 3 Feedlot 6 Oil field water supply 9 Dewatering 12 Other (Specify below) 2 Irrigation 4 Industrial 7 Lawn and garden only 10 Monitoring well Was a chemical/bacteriological sample submitted to Department? Yes No; If yes, mo/day/yr sample was submitted Water Well Disinfected? <u>Yes</u> No
--	--

5 TYPE OF BLANK CASING USED: 1 Steel 3 RMP (SR) 2 PVC 4 ABS Blank casing diameter <u>9</u> in. to <u>20</u> ft., Dia. in. to ft., Dia. in. to ft. Casing height above land surface: <u>2</u> in., weight <u>50</u> lbs./ft. Wall thickness or gauge No. TYPE OF SCREEN OR PERFORATION MATERIAL: 1 Steel 3 Stainless steel 5 Fiberglass 8 RMP (SR) 2 Brass 4 Galvanized steel 6 Concrete tile 9 ABS 11 Other (specify) 12 None used (open hole) SCREEN OR PERFORATION OPENINGS ARE: 1 Continuous slot 3 Mill slot 5 Gauzed wrapped 8 Saw cut 11 None (open hole) 2 Louvered shutter 4 Key punched 6 Wire wrapped 9 Drilled holes 7 Torch cut 10 Other (specify) SCREEN-PERFORATED INTERVALS: From <u>20</u> ft. to <u>40</u> ft., From ft. to ft. GRAVEL PACK INTERVALS: From <u>20</u> ft. to <u>40</u> ft., From ft. to ft.	CASING JOINTS: <u>Glued</u> Clamped Welded Threaded
--	---

6 GROUT MATERIAL: 1 Neat cement 2 Cement grout 3 Bentonite 4 Other Grout Intervals: From <u>0</u> ft. to <u>20</u> ft., From ft. to ft., From ft. to ft. What is the nearest source of possible contamination: 1 Septic tank 4 Lateral lines 7 Pit privy 10 Livestock pens 14 Abandoned water well 2 Sewer lines 5 Cess pool 8 Sewage lagoon 11 Fuel storage 15 Oil well/Gas well 3 Watertight sewer lines 6 Seepage pit 9 Feedyard 12 Fertilizer storage 16 Other (specify below) 13 Insecticide storage Direction from well? <u>South</u> How many feet? <u>110'</u>
---

FROM	TO	LITHOLOGIC LOG	FROM	TO	PLUGGING INTERVALS
0	2	Top Soil			
2	15	Brown Clay			
15	22	Sandy Clay			
22	40	Coarse Sand (Water)			

7 CONTRACTOR'S OR LANDOWNER'S CERTIFICATION: This water well was (1) constructed, (2) reconstructed, or (3) plugged under my jurisdiction and was completed on (mo/day/year) <u>11/10/94</u> and this record is true to the best of my knowledge and belief. Kansas Water Well Contractor's License No. <u>451</u> This Water Well Record was completed on (mo/day/yr) <u>12/2/94</u> under the business name of <u>Holden Hill Drilling</u> by (signature) <u>Craig H. Culp/PE</u>
---