

1	LOCATION OF WATER WELL:	Fraction	Section Number	Township Number	Range Number
County:	GEARY	SW 1/4 NE 1/4 1/4	31	11 S	6 E

Distance and direction from nearest town or city street address of well if located within city?
FORT RILEY, KS. BLDG 388 WP-2

2 WATER WELL OWNER: **US ARMY CORPS OF ENGINEERS**
 RR#, St. Address, Box #: **601 E 12TH ST** Board of Agriculture, Division of Water Resources
 City, State, ZIP Code: **LC, MO, 64106** Application Number:

3	MARK WELL'S LOCATION WITH AN "X" IN SECTION BOX: N	4	DEPTH OF WELL: 29.5ft. WELL'S STATIC WATER LEVEL: 26.8ft. WELL WAS USED AS: 1 Domestic 5 Public Water Supply 9 Dewatering 2 Irrigation 6 Oil Field Water Supply 10 Monitoring Well 3 Feedlot 7 Lawn and Garden Only 11 Injection Well 4 Industrial 8 Air Conditioning 12 Other..... PIEZOMETER																																
<table border="1"> <tr> <td colspan="2">PUEBLO SCS</td> <td colspan="2"></td> </tr> <tr> <td>N</td> <td>W</td> <td>N</td> <td>E</td> </tr> <tr> <td colspan="2">DWG</td> <td colspan="2"></td> </tr> <tr> <td>W</td> <td></td> <td></td> <td>E</td> </tr> <tr> <td colspan="2">ATTACHED</td> <td colspan="2"></td> </tr> <tr> <td>S</td> <td>W</td> <td>S</td> <td>E</td> </tr> <tr> <td colspan="2"></td> <td colspan="2"></td> </tr> <tr> <td colspan="2">S</td> <td colspan="2"></td> </tr> </table>		PUEBLO SCS				N	W	N	E	DWG				W			E	ATTACHED				S	W	S	E					S				Was a chemical/bacteriological sample submitted to Department? Yes.....No X . If yes, mo/day/yr sample was submitted..... Water Well Disinfected: Yes..... No X	
PUEBLO SCS																																			
N	W	N	E																																
DWG																																			
W			E																																
ATTACHED																																			
S	W	S	E																																
S																																			

5 TYPE OF BLANK CASING USED:
 1 Steel 3 RMP (SR) 5 Wrought 7 Fiberglass 9 Other (specify below)
2 PVC 4 ABS 6 Asbestos-Cement 8 Concrete Tile
 Blank casing diameter: **1**.....in. Was casing pulled? Yes **X** No..... If yes, how much: **6**.....
 Casing height above or below land surface: **FLUSH-MTD**.....in.


6 GROUT PLUG MATERIAL: 1 Neat cement 2 Cement grout **3 Bentonite** 4 Other.....
 Grout Plug Intervals: From **29.5**.....ft. to **6**.....ft., From.....ft. to.....ft., From..... to.....ft.
 What is the nearest source of possible contamination:
 1 Septic tank 6 Seepage pit 11 Fuel storage **16 Other (specify below)**
 2 Sewer lines 7 Pit privy 12 Fertilizer storage
 3 Watertight sewer lines 8 Sewage lagoon 13 Insecticide storage
 4 Lateral lines 9 Feedyard 14 Abandoned water well
 5 Cess Pool 10 Livestock pens 15 Oil well/Gas well
FORMER UST SITE
 Direction from well? How many feet?

FROM	TO	PLUGGING MATERIALS
29.5	6	Bentonite slurry
6	0	Clay & native soil

GEOPOROUS GROUT PUMP

7 CONTRACTOR'S OR LANDOWNER'S CERTIFICATION: This water well was plugged under my jurisdiction and was completed on (mo/day/year) **4-10-98**..... and this record is true to the best of my knowledge and belief. Kansas Water Well Contractor's License No. **896**..... This Water Well Record was completed on (mo/day/year) **4-17-98**..... under the business name of **ESCC a.k.a. PSA ENV.**
 by (signature) **[Signature]**

INSTRUCTIONS: Use typewriter or ball point pen. Please press firmly and print clearly. Please fill in blanks, underline or circle the correct answers. Send top three copies to Kansas Department of Health and Environment, Bureau of Water, Topeka, Kansas 66620-0001. Telephone: 913/296-3565. Send one to Water Well Owner and retain one for your records.

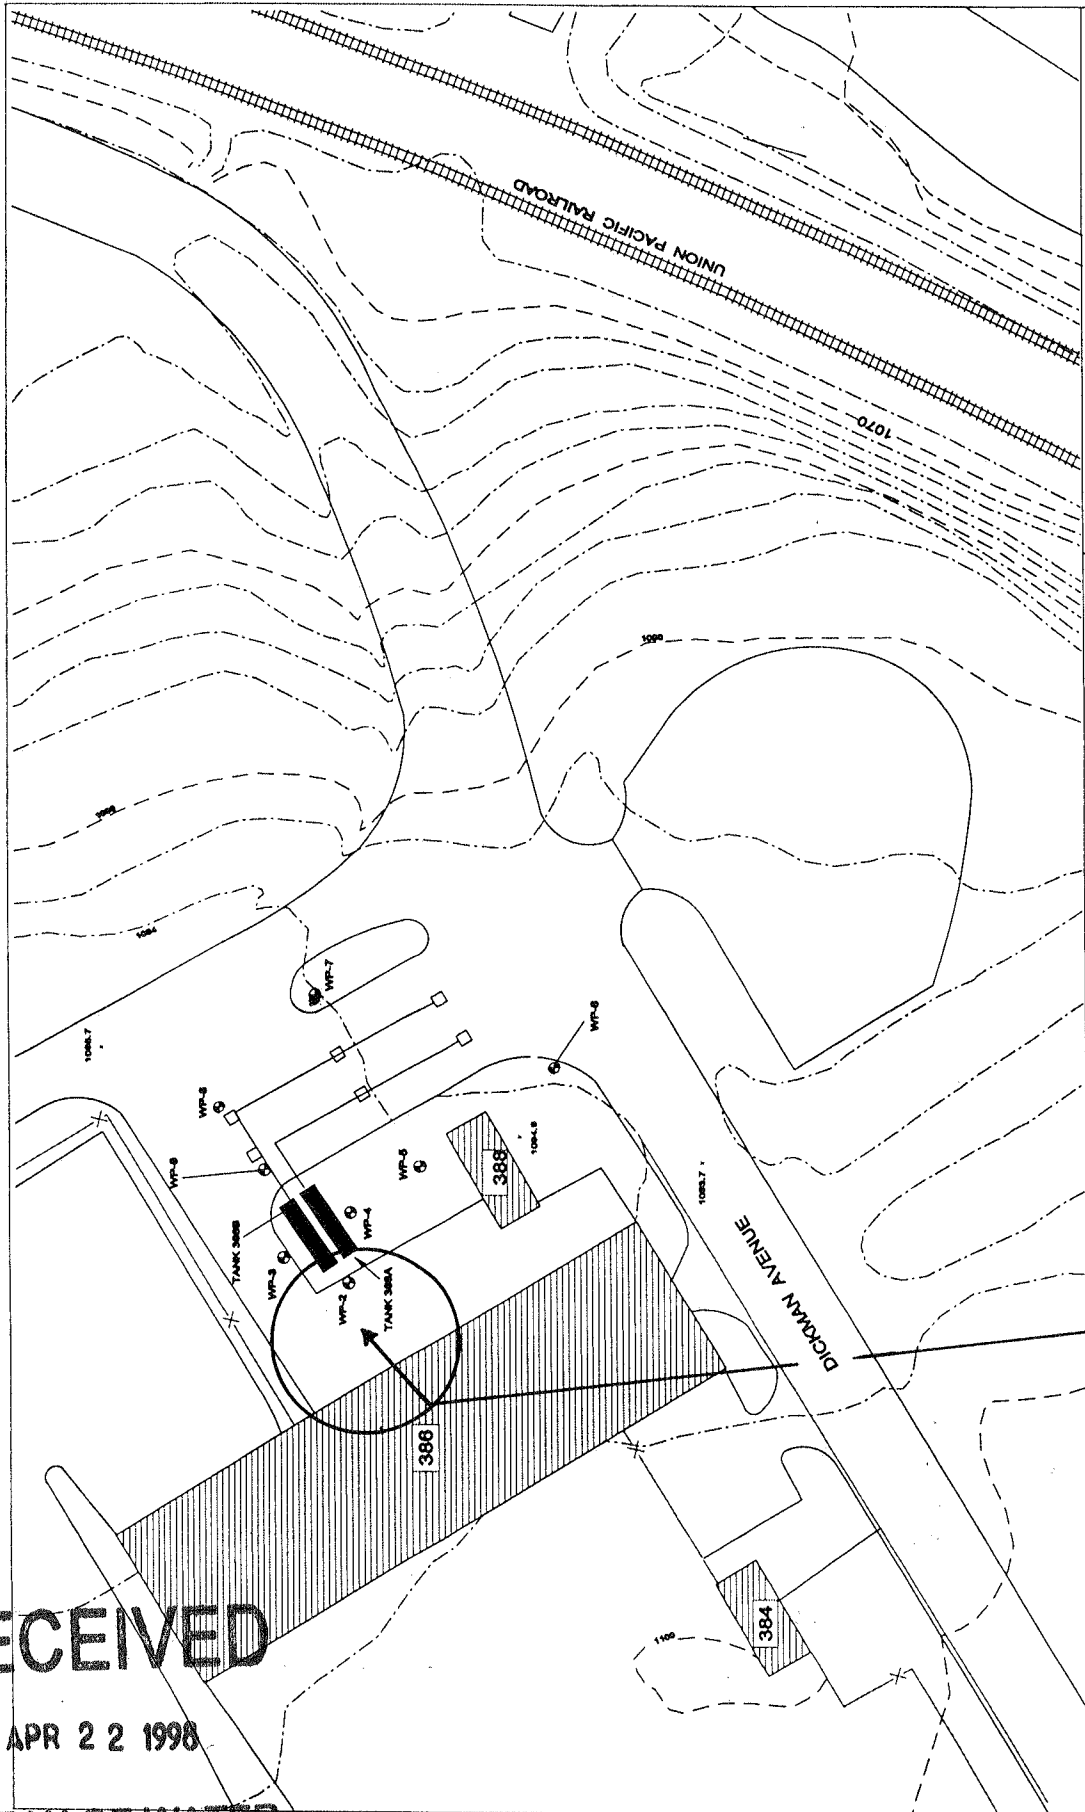

HydroGeoLogic, Inc.
 Fort Riley, Kansas
 For
 U.S. Army Corps of Engineers

FIGURES 5.8
 BUILDING 388
 WELL POINT
 ABANDONMENT LOCATIONS

DATE: 03/04/98

LEGEND:

- ◊ - MONITORING WELL LOCATION
- ⊕ - LOCATION OF URT
- ⊗ - FENCE
- ▭ - LAND ELEVATION VALUES
- ▭ - BUILDING AND BUILDING NUMBER

SCALE IN FEET

50 25 0 50

NORTH

2
 PIEZOMETER
 BLDG 388

RECEIVED
 APR 22 1998
 BUREAU OF WATER