


1 LOCATION OF WATER WELL: Fraction SW 1/4 NE 1/4 Section Number 31 Township Number T 11 S Range Number R 6 E

Distance and direction from nearest town or city street address of well if located within city?
 Four Riley KS BLDG 388 WP-3

2 WATER WELL OWNER: US ARMY CORPS OF ENGINEERS
 RR#, St. Address, Box #: 601 E 12TH ST
 City, State, ZIP Code: KC, MO, 64106
 Board of Agriculture, Division of Water Resources
 Application Number:

3 LOCATE WELL'S LOCATION WITH AN "X" IN SECTION BOX: 4 DEPTH OF COMPLETED WELL 31 ft. ELEVATION: 1099.73

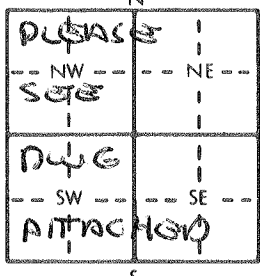

Depth(s) Groundwater Encountered 1. ~~31~~ 27.8 ft. 2. ft. 3. ft.
 WELL'S STATIC WATER LEVEL 24.2 ft. below land surface measured on mo/day/yr 3-3-95
 Pump test data: Well water was ft. after hours pumping gpm
 Est. Yield gpm: Well water was ft. after hours pumping gpm
 Bore Hole Diameter 1 in. to ft. and in. to ft.
 WELL WATER TO BE USED AS:
 1 Domestic 3 Feedlot 6 Oil field water supply 8 Air conditioning 11 Injection well
 2 Irrigation 4 Industrial 7 Lawn and garden only 9 Dewatering 12 Other (Specify below)
 PIEZOMETER
 Was a chemical/bacteriological sample submitted to Department? Yes.....No.....; If yes, mo/day/yr sample was submitted
 Water Well Disinfected? Yes No

5 TYPE OF BLANK CASING USED:
 1 Steel 3 RMP (SR) 5 Wrought iron 8 Concrete tile CASING JOINTS: Glued Clamped Welded Threaded
 2 PVC 4 ABS 7 Fiberglass 9 Other (specify below)
 Blank casing diameter 1 in. to 2.8 ft., Dia. 1 in. to ft., Dia. in. to ft.
 Casing height above land surface FLUSH in., weight lbs./ft. Wall thickness or gauge No.

TYPE OF SCREEN OR PERFORATION MATERIAL:
 1 Steel 3 Stainless steel 5 Fiberglass 7 PVC 10 Asbestos-cement
 2 Brass 4 Galvanized steel 6 Concrete tile 8 RMP (SR) 11 Other (specify)
 9 ABS 12 None used (open hole)

SCREEN OR PERFORATION OPENINGS ARE:
 1 Continuous slot 3 Mill slot .010 5 Gauzed wrapped 8 Saw cut 11 None (open hole)
 2 Louvered shutter 4 Key punched 6 Wire wrapped 9 Drilled holes
 7 Torch cut 10 Other (specify)

SCREEN-PERFORATED INTERVALS: From 31 ft. to 27 ft., From ft. to ft.
 From ft. to ft., From ft. to ft.
 GRAVEL PACK INTERVALS: From ft. to ft., From ft. to ft.
 From ft. to ft., From ft. to ft.

6 GROUT MATERIAL: 1 Neat cement 2 Cement grout 3 Bentonite 4 Other
 Grout Intervals: From 31 ft. to ft., From ft. to ft., From ft. to ft.

What is the nearest source of possible contamination:
 1 Septic tank 4 Lateral lines 7 Pit privy 10 Livestock pens 14 Abandoned water well
 2 Sewer lines 5 Cess pool 8 Sewage lagoon 11 Fuel storage 15 Oil well/Gas well
 3 Watertight sewer lines 6 Seepage pit 9 Feedyard 12 Fertilizer storage 16 Other (specify below)
 UST SITE
 Direction from well? How many feet?

FROM	TO	LITHOLOGIC LOG	FROM	TO	PLUGGING INTERVALS
0	31	DIRECT PUSA NO CUTTINGS			

7 CONTRACTOR'S OR LANDOWNER'S CERTIFICATION: This water well was (1) constructed, (2) reconstructed, or (3) plugged under my jurisdiction and was completed on (mo/day/year) 3-2-95 and this record is true to the best of my knowledge and belief. Kansas Water Well Contractor's License No. 606 This Water Well Record was completed on (mo/day/yr) 9-19-98 under the business name of ESCC dba PSA ENVIRONMENTAL by signature

RECEIVED

APR 22 1996

BUREAU OF WATER

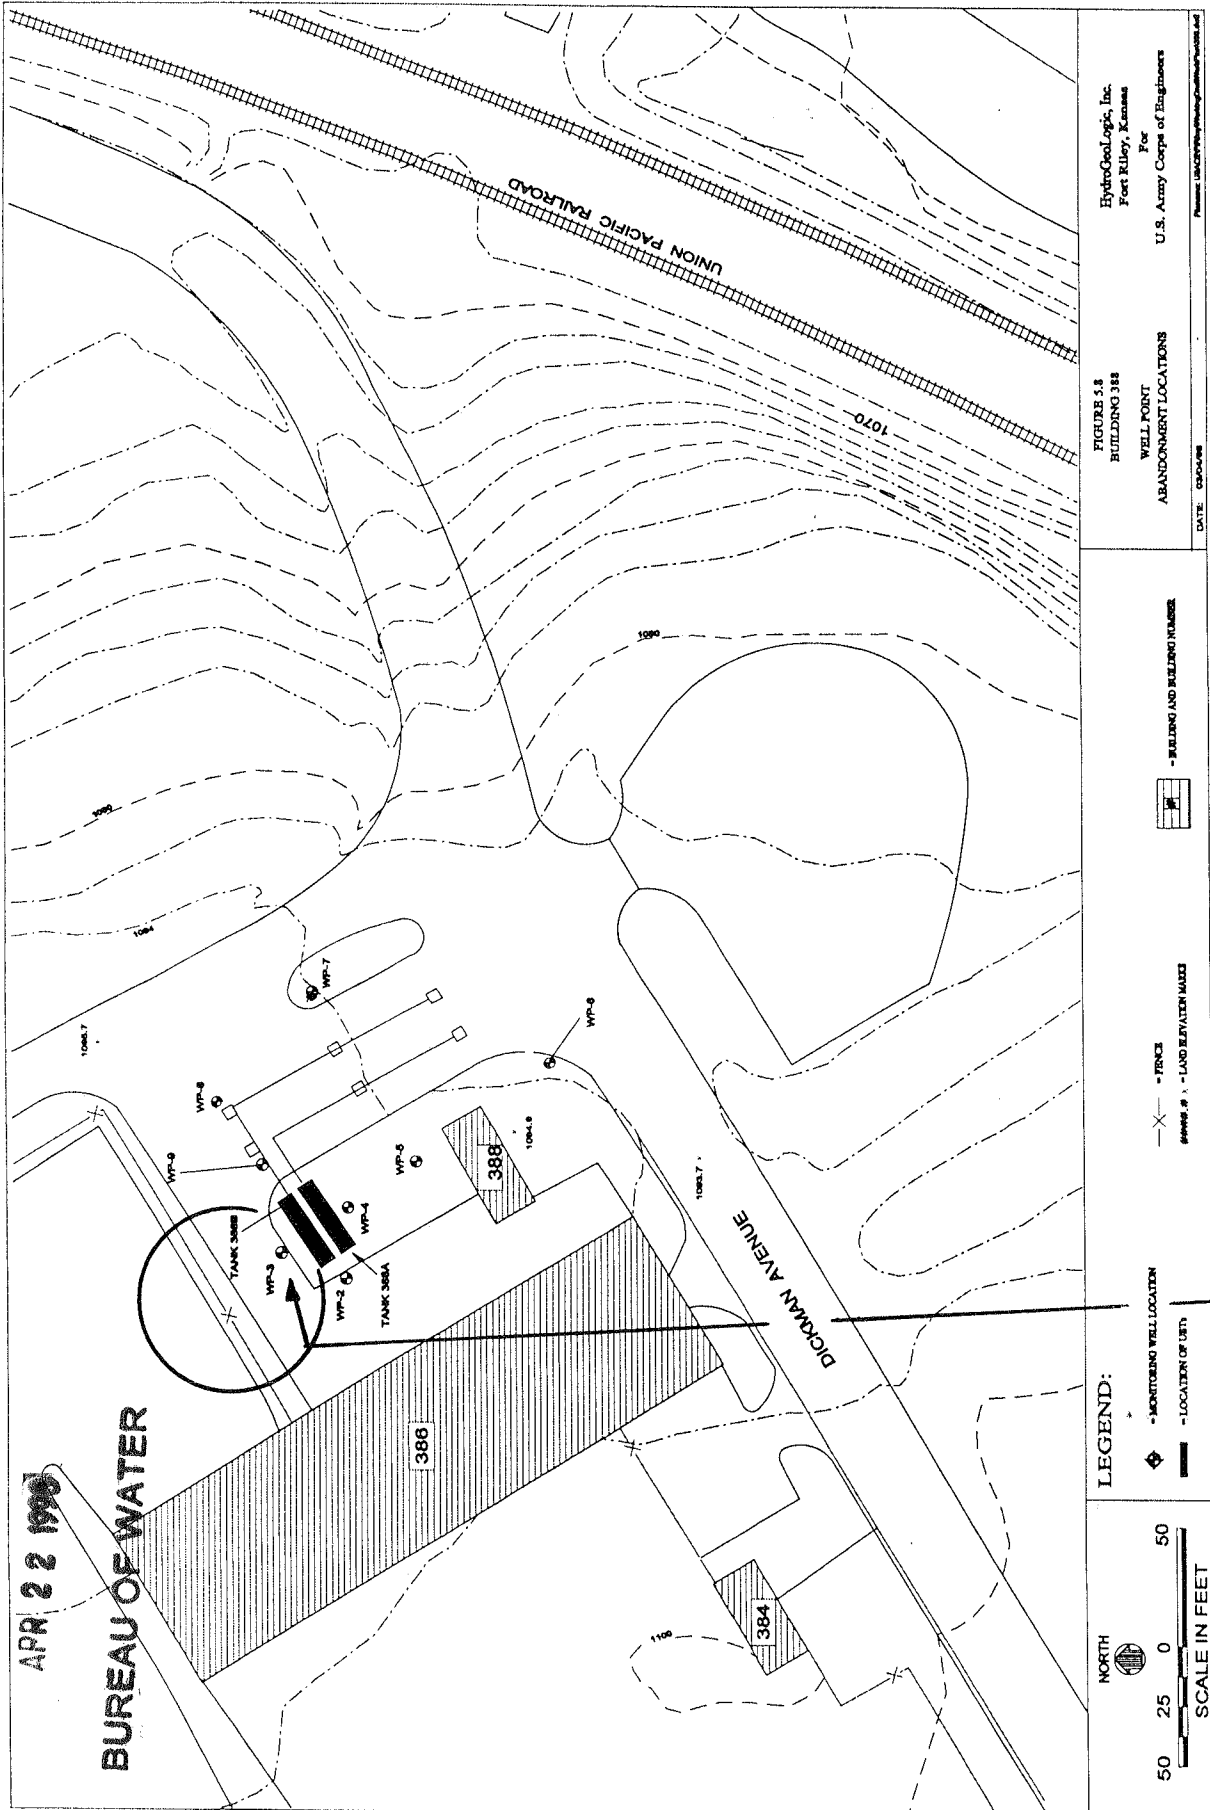


FIGURE 5.8
BUILDING 388
WELL POINT
ABANDONMENT LOCATIONS
DATE: 03-04-96

HydroGeoLogic, Inc.
Fort Riley, Kansas
For
U.S. Army Corps of Engineers

— BUILDING AND BUILDING NUMBER
— FENCE
— LAND ELEVATION MARK

LEGEND:
♦ — MONITORING WELL LOCATION
◆ — LOCATION OF UTI

NORTH

50 25 0 50
SCALE IN FEET

#3
PIEZOMETER
BLOG 388