

1	LOCATION OF WATER WELL:	Fraction	Section Number	Township Number	Range Number
	County: <u>Geary</u>	<u>SW 1/4 NE 1/4</u> 1/4	<u>31</u>	<u>11 S</u>	<u>6 E</u>

Distance and direction from nearest town or city street address of well if located within city?  
FORT RILEY, KS, BLDG 388 WP-4

2 WATER WELL OWNER: US ARMY CORPS OF ENGINEERS  
601 E 12TH ST  
 RR#, St. Address, Box #: KC, MO 64163  
 City, State, ZIP Code: KC, MO 64163 Board of Agriculture, Division of Water Resources  
 Application Number:

3	MARK WELL'S LOCATION WITH AN "X" IN SECTION BOX: N	4	DEPTH OF WELL: <u>28.3</u> .....ft. WELL'S STATIC WATER LEVEL: <u>26.2</u> .....ft. WELL WAS USED AS: 1 Domestic 5 Public Water Supply 9 Dewatering 2 Irrigation 6 Oil Field Water Supply 10 Monitoring Well 3 Feedlot 7 Lawn and Garden Only 11 Injection Well 4 Industrial 8 Air Conditioning 12 Other..... <u>PIEZOMETER</u>																								
<table border="1"> <tr> <td colspan="2">PLUGGED SECS</td> <td colspan="2"></td> </tr> <tr> <td>N W</td> <td>N E</td> <td colspan="2"></td> </tr> <tr> <td colspan="2">DWG</td> <td colspan="2"></td> </tr> <tr> <td>W</td> <td></td> <td>E</td> <td></td> </tr> <tr> <td colspan="2">S W</td> <td colspan="2">S E</td> </tr> <tr> <td colspan="4">S</td> </tr> </table>		PLUGGED SECS				N W	N E			DWG				W		E		S W		S E		S				<p>Was a chemical/bacteriological sample submitted to Department? Yes....No <u>X</u>          If yes, mo/day/yr sample was submitted.....          Water Well Disinfected: Yes..... No <u>X</u>...</p>	
PLUGGED SECS																											
N W	N E																										
DWG																											
W		E																									
S W		S E																									
S																											

5 TYPE OF BLANK CASING USED:  
 1 Steel 3 RMP (SR) 5 Wrought 7 Fiberglass 9 Other (specify below)  
2 PVC 4 ABS 6 Asbestos-Cement 8 Concrete Tile .....

Blank casing diameter: 1.....in. Was casing pulled? Yes..... No X... If yes, how much.....  
 Casing height above or below land surface: FLUSA.....in. MOUNTED

6 GROUT PLUG MATERIAL: 1 Neat cement 2 Cement grout 3 Bentonite 4 Other.....  
 Grout Plug Intervals: From.....ft. to.....ft., From.....ft. to.....ft., From..... to.....ft.  
 What is the nearest source of possible contamination:  
 1 Septic tank 6 Seepage pit 11 Fuel storage 16 Other (specify below)  
 2 Sewer lines 7 Pit privy 12 Fertilizer storage .....

FROM	TO	PLUGGING MATERIALS
		<u>WELL NOT LOCATED</u>
		<u>DUE TO EXCAVATION</u>
		<u>+ CONSTRUCTION ACTIVITIES</u>

7 CONTRACTOR'S OR LANDOWNER'S CERTIFICATION: This water well was plugged under my jurisdiction and was completed on (mo/day/year)..... and this record is true to the best of my knowledge and belief. Kansas Water Well Contractor's License No. 606..... This Water Well Record was completed on (mo/day/year) 4-14-98..... under the business name of ESSC dba PSA Environmental by (signature) [Signature].....

INSTRUCTIONS: Use typewriter or ball point pen. Please press firmly and print clearly. Please fill in blanks, underline or circle the correct answers. Send top three copies to Kansas Department of Health and Environment, Bureau of Water, Topeka, Kansas 66620-0001. Telephone: 913/296-3565. Send one to Water Well Owner and retain one for your records.

**RECEIVED**

APR 22 1998

BUREAU OF WATER

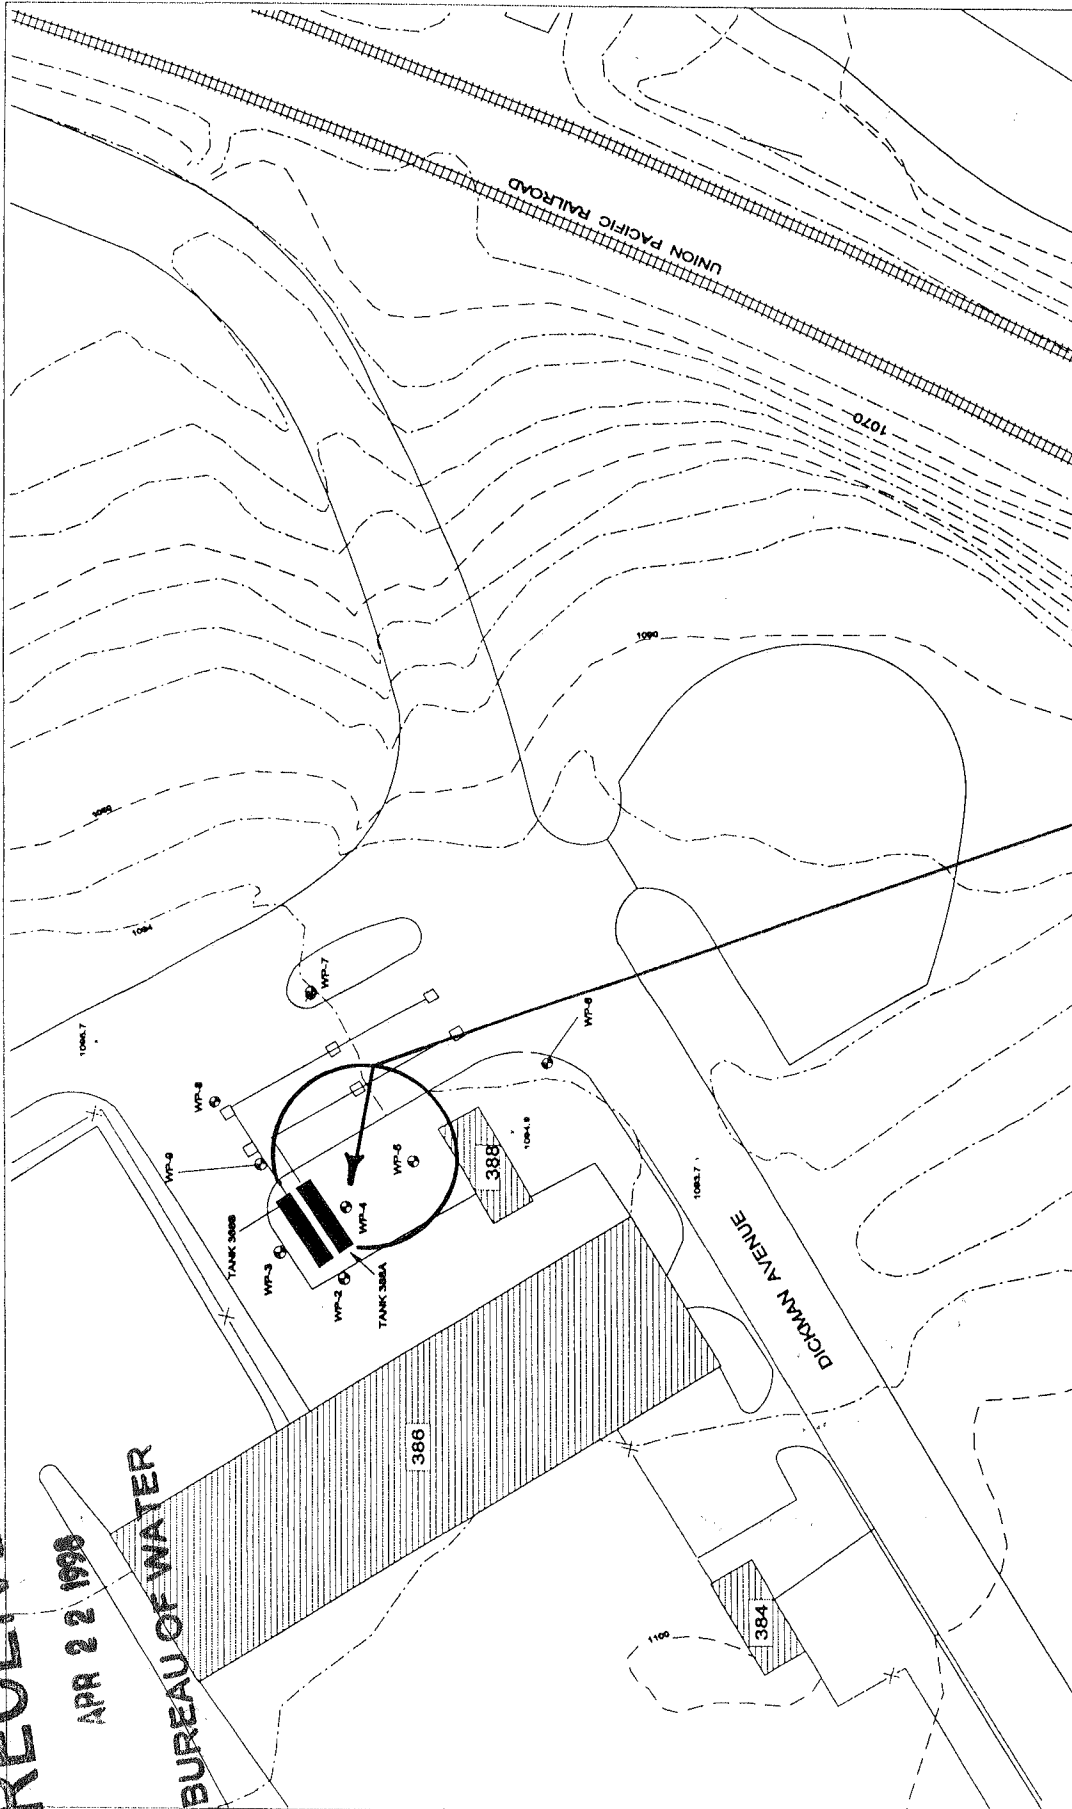


FIGURE 5-8  
BUILDING 388  
WELL POINT  
ABANDONMENT LOCATIONS  
DATE: 03/04/98

HydroGeoLogic, Inc.  
Fort Riley, Kansas  
For  
U.S. Army Corps of Engineers

LEGEND:  
 ◆ - MONITORING WELL LOCATION  
 - - - - LAND RELAY WATER TABLE  
 -X- - FENCE  
 [Hatched Box] - BUILDING AND BUILDING NUMBER



#4  
PIEZOMETER  
BLDG 388