


[illegible]

RECEIVED

APR 22 1990

BUREAU OF WATER

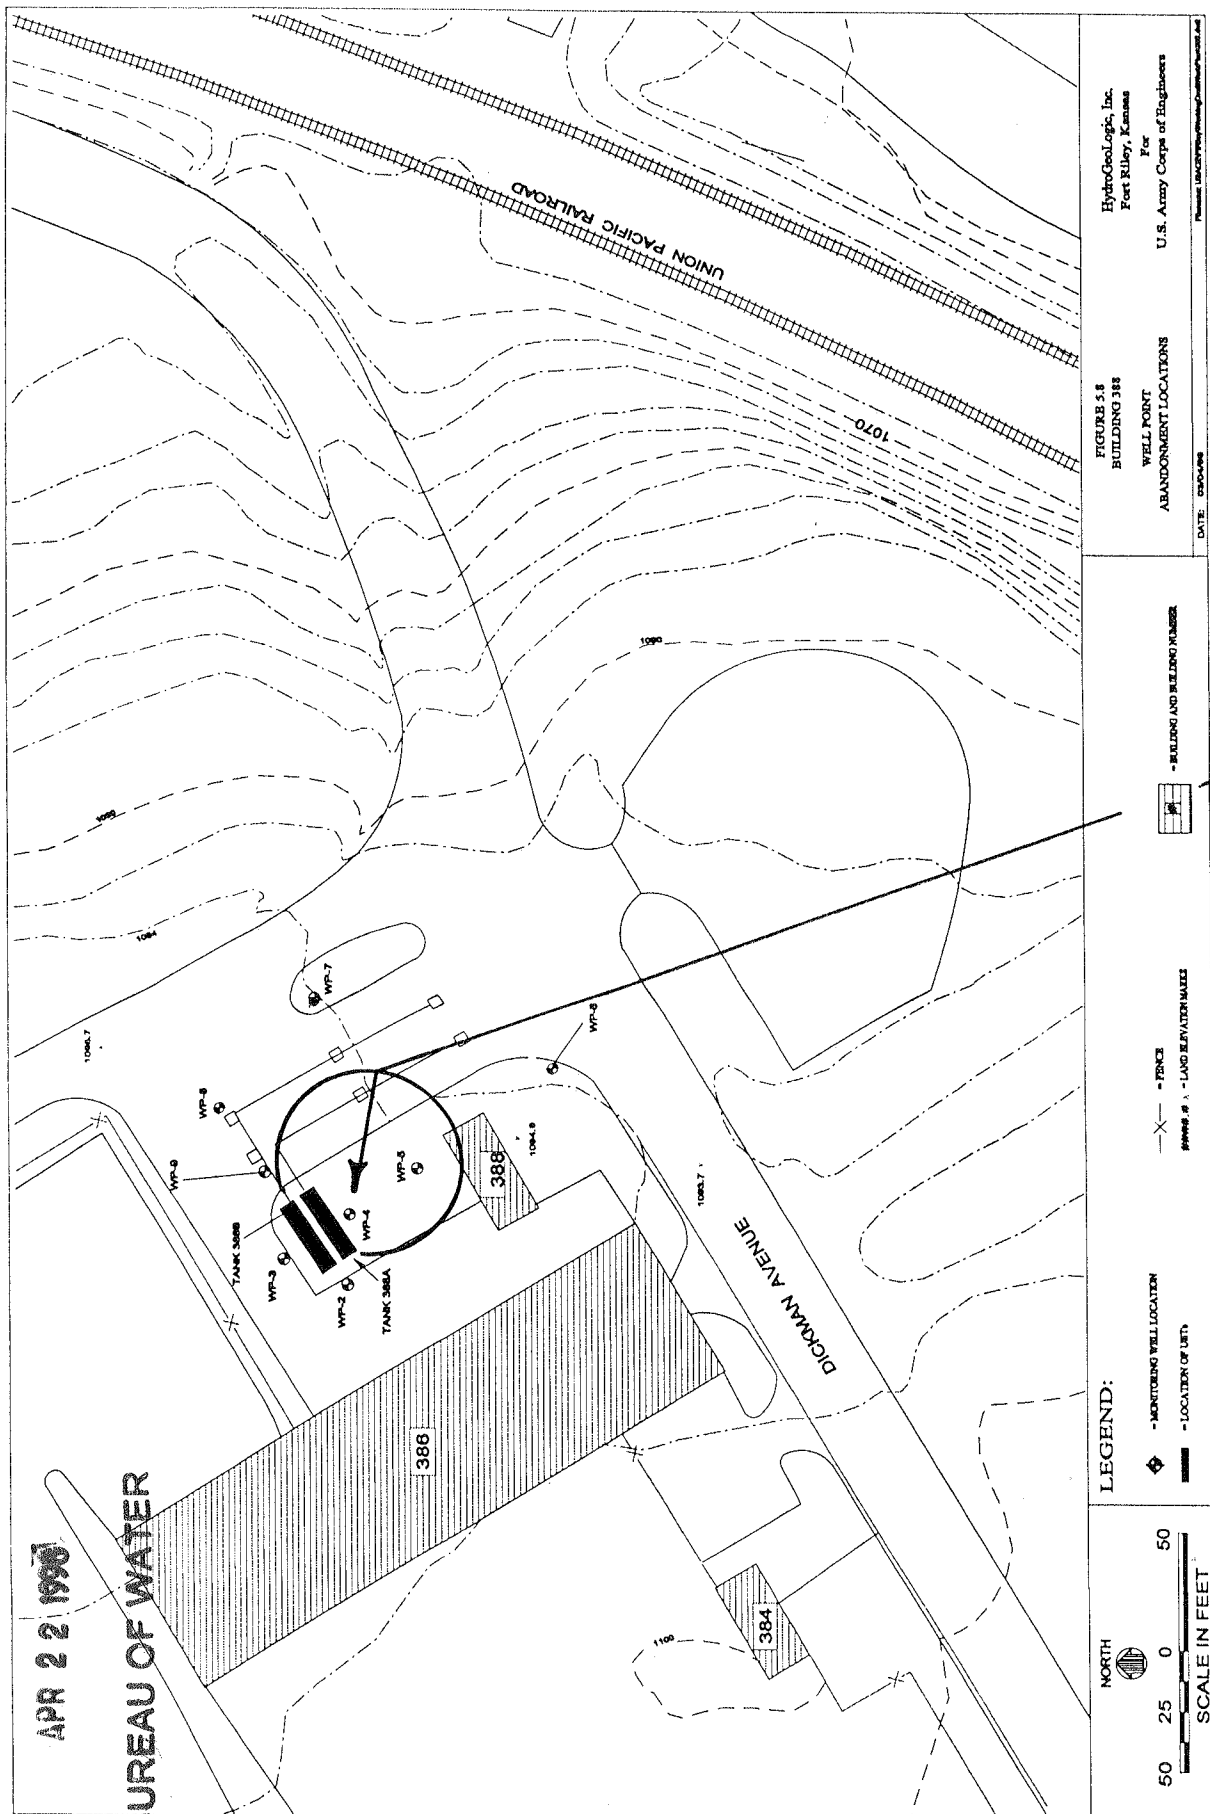

PIEZOMETER #4
BLOG 388