


1 LOCATION OF WATER WELL: County: GEOLOGY	Fraction SW 1/4 NE 1/4 1/4	Section Number 31	Township Number 11 S	Range Number 6-E																										
Distance and direction from nearest town or city street address of well if located within city? F+ RILEY, KS. CAMP FUNSTON FORMER BLDG 1044 WP-4																														
2 WATER WELL OWNER: US ARMY CORPS OF ENGINEERS																														
RR#, St. Address, Box #: 601 E 12TH ST City, State, ZIP Code : KC, MO 64106																														
Board of Agriculture, Division of Water Resources Application Number:																														
3 MARK WELL'S LOCATION WITH AN "X" IN SECTION BOX: N <table border="1" style="width:100%; text-align: center; border-collapse: collapse;"> <tr><td colspan="2">PLS SOB</td></tr> <tr><td>N W</td><td>N E</td></tr> <tr><td colspan="2">ATTACHED</td></tr> <tr><td>W</td><td>E</td></tr> <tr><td colspan="2">DUG</td></tr> <tr><td>S W</td><td>S E</td></tr> <tr><td colspan="2">S</td></tr> </table>		PLS SOB		N W	N E	ATTACHED		W	E	DUG		S W	S E	S		4 DEPTH OF WELL... 24.0ft. WELL'S STATIC WATER LEVEL... 29.1ft. WELL WAS USED AS: <table style="width:100%;"> <tr><td>1 Domestic</td><td>5 Public Water Supply</td><td>9 Dewatering</td></tr> <tr><td>2 Irrigation</td><td>6 Oil Field Water Supply</td><td>10 Monitoring Well</td></tr> <tr><td>3 Feedlot</td><td>7 Lawn and Garden Only</td><td>11 Injection Well</td></tr> <tr><td>4 Industrial</td><td>8 Air Conditioning</td><td>12 Other.....</td></tr> </table> PIEZOMETER Was a chemical/bacteriological sample submitted to Department? Yes....No... If yes, mo/day/yr sample was submitted..... Water Well Disinfected: Yes..... No... X			1 Domestic	5 Public Water Supply	9 Dewatering	2 Irrigation	6 Oil Field Water Supply	10 Monitoring Well	3 Feedlot	7 Lawn and Garden Only	11 Injection Well	4 Industrial	8 Air Conditioning	12 Other.....
PLS SOB																														
N W	N E																													
ATTACHED																														
W	E																													
DUG																														
S W	S E																													
S																														
1 Domestic	5 Public Water Supply	9 Dewatering																												
2 Irrigation	6 Oil Field Water Supply	10 Monitoring Well																												
3 Feedlot	7 Lawn and Garden Only	11 Injection Well																												
4 Industrial	8 Air Conditioning	12 Other.....																												
5 TYPE OF BLANK CASING USED: <table style="width:100%;"> <tr><td>1 Steel</td><td>3 RMP (SR)</td><td>5 Wrought</td><td>7 Fiberglass</td><td>9 Other (specify below)</td></tr> <tr><td>2 PVC</td><td>4 ABS</td><td>6 Asbestos-Cement</td><td>8 Concrete Tile</td><td></td></tr> </table> Blank casing diameter... 1in. Was casing pulled? Yes... X ... No..... If yes, how much... 3.5 Casing height above or below land surface... FLUSA MTBin.					1 Steel	3 RMP (SR)	5 Wrought	7 Fiberglass	9 Other (specify below)	2 PVC	4 ABS	6 Asbestos-Cement	8 Concrete Tile																	
1 Steel	3 RMP (SR)	5 Wrought	7 Fiberglass	9 Other (specify below)																										
2 PVC	4 ABS	6 Asbestos-Cement	8 Concrete Tile																											
6 GROUT PLUG MATERIAL: 1 Neat cement 2 Cement grout 3 Bentonite 4 Other..... Grout Plug Intervals: From... 24ft. to 3.4ft., From.....ft. toft., From..... toft. What is the nearest source of possible contamination: <table style="width:100%;"> <tr><td>1 Septic tank</td><td>6 Seepage pit</td><td>11 Fuel storage</td><td>16 Other (specify below)</td></tr> <tr><td>2 Sewer lines</td><td>7 Pit privy</td><td>12 Fertilizer storage</td><td></td></tr> <tr><td>3 Watertight sewer lines</td><td>8 Sewage lagoon</td><td>13 Insecticide storage</td><td>FORMER UST</td></tr> <tr><td>4 Lateral lines</td><td>9 Feedyard</td><td>14 Abandoned water well</td><td>SITE</td></tr> <tr><td>5 Cess Pool</td><td>10 Livestock pens</td><td>15 Oil well/Gas well</td><td></td></tr> </table> Direction from well? How many feet?					1 Septic tank	6 Seepage pit	11 Fuel storage	16 Other (specify below)	2 Sewer lines	7 Pit privy	12 Fertilizer storage		3 Watertight sewer lines	8 Sewage lagoon	13 Insecticide storage	FORMER UST	4 Lateral lines	9 Feedyard	14 Abandoned water well	SITE	5 Cess Pool	10 Livestock pens	15 Oil well/Gas well							
1 Septic tank	6 Seepage pit	11 Fuel storage	16 Other (specify below)																											
2 Sewer lines	7 Pit privy	12 Fertilizer storage																												
3 Watertight sewer lines	8 Sewage lagoon	13 Insecticide storage	FORMER UST																											
4 Lateral lines	9 Feedyard	14 Abandoned water well	SITE																											
5 Cess Pool	10 Livestock pens	15 Oil well/Gas well																												
<table border="1" style="width:100%; border-collapse: collapse;"> <thead> <tr> <th style="width:10%;">FROM</th> <th style="width:10%;">TO</th> <th style="width:80%;">PLUGGING MATERIALS</th> </tr> </thead> <tbody> <tr> <td>24.0</td> <td>3.4</td> <td>Bentonite</td> </tr> <tr> <td>3.4</td> <td>0</td> <td>CLAY HUNTING SOIL</td> </tr> <tr><td> </td><td> </td><td> </td></tr> <tr><td> </td><td> </td><td> </td></tr> <tr><td> </td><td> </td><td> </td></tr> <tr><td> </td><td> </td><td> </td></tr> <tr><td> </td><td> </td><td> </td></tr> </tbody> </table> GEOPADRE GROUT MACHINE TROMI LINE					FROM	TO	PLUGGING MATERIALS	24.0	3.4	Bentonite	3.4	0	CLAY HUNTING SOIL																	
FROM	TO	PLUGGING MATERIALS																												
24.0	3.4	Bentonite																												
3.4	0	CLAY HUNTING SOIL																												
7 CONTRACTOR'S OR LANDOWNER'S CERTIFICATION: This water well was plugged under my jurisdiction and was completed on (mo/day/year) 4-9-98 and this record is true to the best of my knowledge and belief. Kansas Water Well Contractor's License No. 606 This Water Well Record was completed on (mo/day/year) 4-18-98 under the business name of ESCC Aba. PSA. QV. by (signature) [Signature]																														
INSTRUCTIONS: Use typewriter or ball point pen. Please press firmly and print clearly. Please fill in blanks, underline or circle the correct answers. Send top three copies to Kansas Department of Health and Environment, Bureau of Water, Topeka, Kansas 66620-0001. Telephone: 913/296-3565. Send one to Water Well Owner and retain one for your records.																														

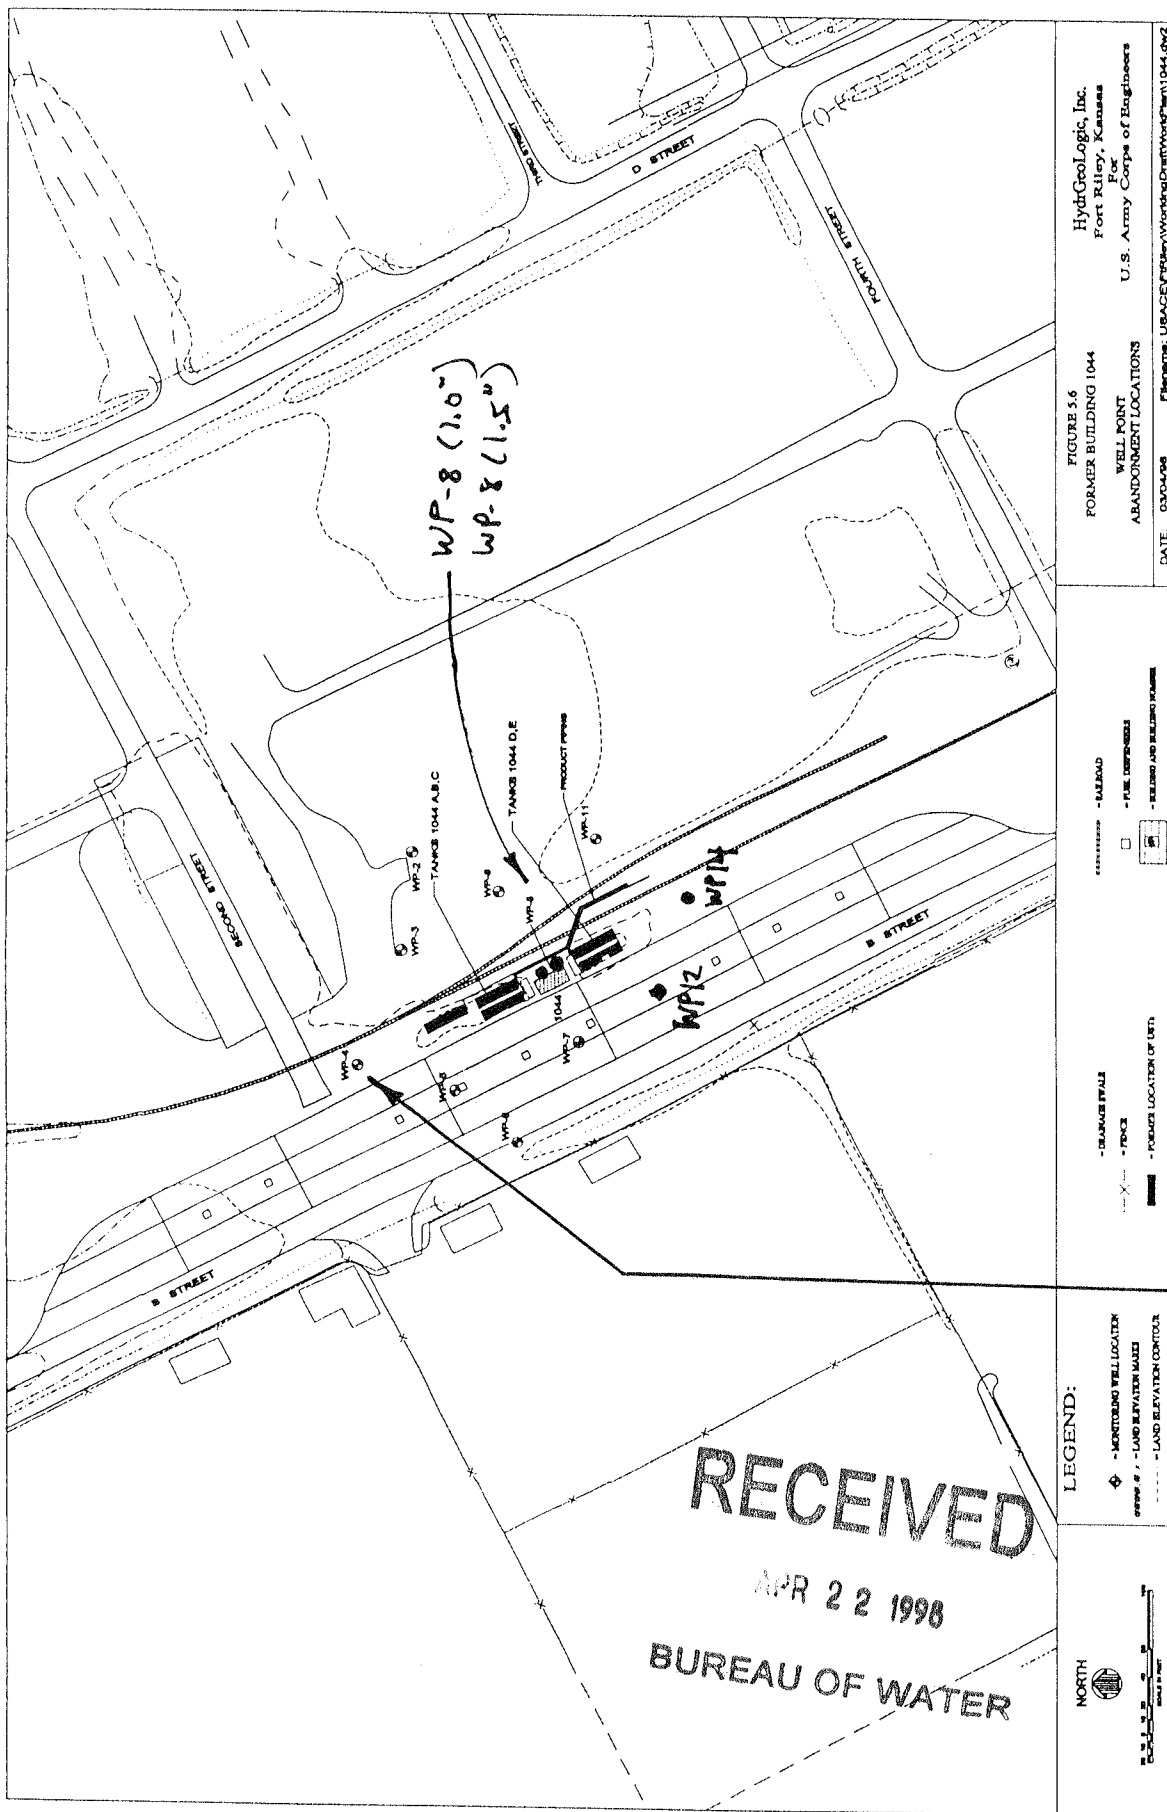

PIEZOMETER WP-4
FORMER BLDG 1044