

1	LOCATION OF WATER WELL:	Fraction	Section Number	Township Number	Range Number
	County: GEARY	SW 1/4 NE 1/4 1/4	31	11	6 E

Distance and direction from nearest town or city street address of well if located within city?
FORT RILEY KS CAMP FUSTON FARMER BUDG 1245 WP-4

2 WATER WELL OWNER: **US ARMY CORPS OF ENGINEERS**
 RR#, St. Address, Box #: **601 E. 12TH ST**
 City, State, ZIP Code: **KC, MO. 64106**
 Board of Agriculture, Division of Water Resources
 Application Number:

3 MARK WELL'S LOCATION WITH AN "X" IN SECTION BOX:

N			
SW	SE	NE	NW
X			
S			

Diagram description: A 2x2 grid with 'N' at the top and 'S' at the bottom. The top-left quadrant is labeled 'SW' and contains 'X'. The top-right quadrant is labeled 'SE'. The bottom-left quadrant is labeled 'NW' and contains 'DWG'. The bottom-right quadrant is labeled 'NE'. The text 'SEE ATTACHED' is written across the top.

4 DEPTH OF WELL... **23**ft.
 WELL'S STATIC WATER LEVEL... **1.8**ft.
 WELL WAS USED AS:

1 Domestic	5 Public Water Supply	9 Dewatering
2 Irrigation	6 Oil Field Water Supply	10 Monitoring Well
3 Feedlot	7 Lawn and Garden Only	11 Injection Well
4 Industrial	8 Air Conditioning	12 Other. PIEZOMETER.

Was a chemical/bacteriological sample submitted to Department? Yes....No **X**.
 If yes, mo/day/yr sample was submitted.....
 Water Well Disinfected: Yes..... No **X**...

5 TYPE OF BLANK CASING USED:

1 Steel	3 RMP (SR)	5 Wrought	7 Fiberglass	9 Other (specify below)
2 PVC	4 ABS	6 Asbestos-Cement	8 Concrete Tile	

Blank casing diameter... **1**in. Was casing pulled? Yes... **X**... No..... If yes, how much **23** ~~23~~
 Casing height above or below land surface... **FLUSH**in.

6 GROUT PLUG MATERIAL: 1 Neat cement 2 Cement grout **3 Bentonite** 4 Other.....
 Grout Plug Intervals: From.....ft. to.....ft., From.....ft. toft., From..... to.....ft.
 What is the nearest source of possible contamination:

1 Septic tank	6 Seepage pit	11 Fuel storage	16 Other (specify below)
2 Sewer lines	7 Pit privy	12 Fertilizer storage	FORMER
3 Watertight sewer lines	8 Sewage lagoon	13 Insecticide storage	UST SITE
4 Lateral lines	9 Feedyard	14 Abandoned water well	
5 Cess Pool	10 Livestock pens	15 Oil well/Gas well	


Direction from well? How many feet?

FROM	TO	PLUGGING MATERIALS
23	3	BENTONITE SLURRY
3	0	NATIVE SOIL + clay

4-8-98

7 CONTRACTOR'S OR LANDOWNER'S CERTIFICATION: This water well was plugged under my jurisdiction and was completed on (mo/day/year) **2-26-95**... and this record is true to the best of my knowledge and belief. Kansas Water Well Contractor's License No. **600**..... This Water Well Record was completed on (mo/day/year) **4-14-98**..... under the business name of **ENV. SCI. + CLM. CORP. INC.**..... by (signature) **[Signature]**..... (**P.S.A. ENVIRONMENTAL**).....

INSTRUCTIONS: Use typewriter or ball point pen. Please press firmly and print clearly. Please fill in blanks, underline or circle the correct answers. Send top three copies to Kansas Department of Health and Environment, Bureau of Water, Topeka, Kansas 66620-0001. Telephone: 913/296-3565. Send one to Water Well Owner and retain one for your records.

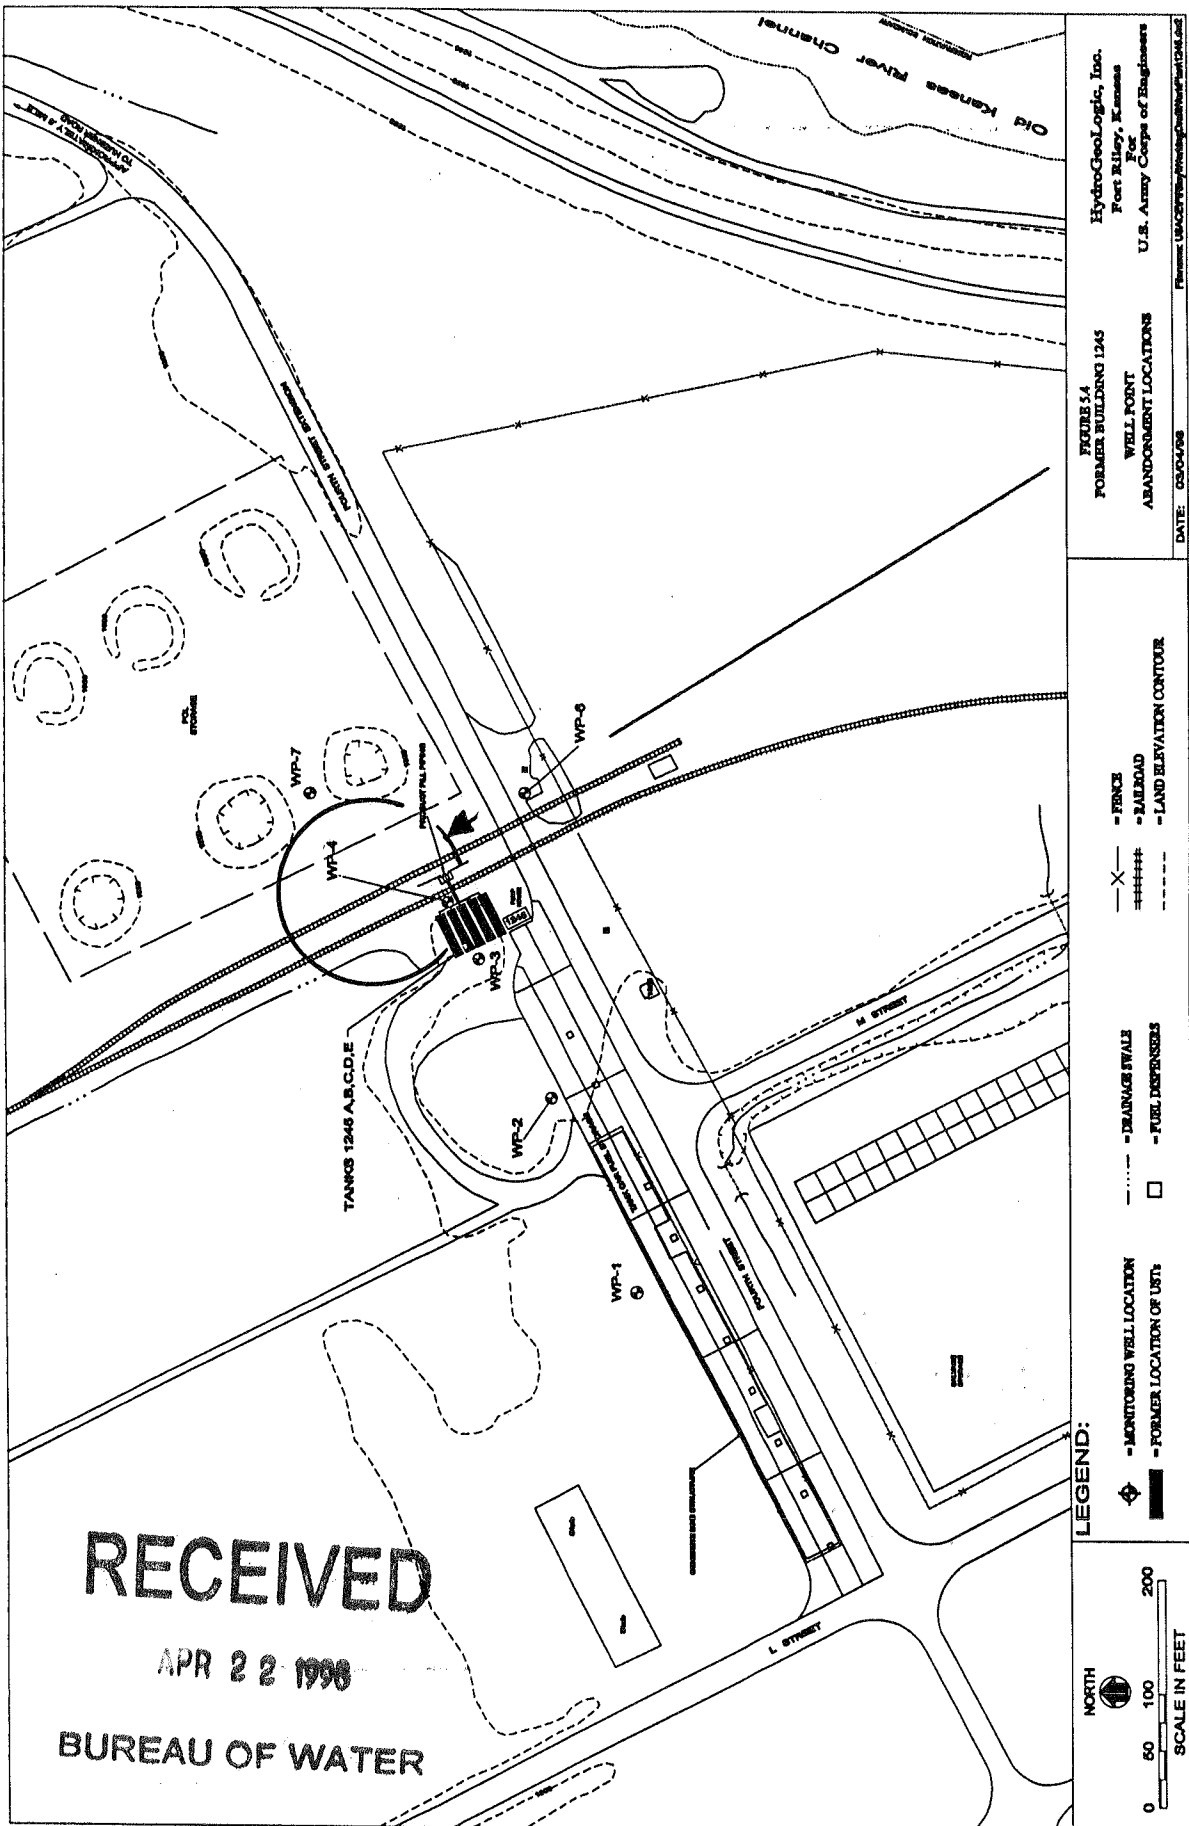

RECEIVED
 APR 22 1998
 BUREAU OF WATER

FIGURE 5.4
 FORMER BUILDING 1245
 WELL POINT
 ABANDONMENT LOCATIONS
 DATE: 03/04/98

HydroGeoLogic, Inc.
 Fort Riley, Kansas
 For
 U.S. Army Corps of Engineers

PIEZOMETER # 4
 FORMER BLDG 1245