

1	LOCATION OF WATER WELL:	Fraction	Section Number	Township Number	Range Number
County:	<u>GENNY</u>	<u>SW 1/4 NE 1/4 1/4</u>	<u>31</u>	<u>11</u>	<u>6-E</u>

Distance and direction from nearest town or city street address of well if located within city?  
Front Riley, KS, MAIN POST BLDG 388 WP-5

2	WATER WELL OWNER:	Board of Agriculture, Division of Water Resources
RR#, St. Address, Box #:	<u>US ARMY CORPS of ENGINEERS</u>	Application Number:
City, State, ZIP Code :	<u>601 E 12TH ST</u> <u>KC, MO 64106</u>	

3	MARK WELL'S LOCATION WITH AN "X" IN SECTION BOX:
N	
W	E
S	S

PLEASE SEE ATTACHED DWG

4	DEPTH OF WELL.. <u>2.8</u> ..ft.												
	WELL'S STATIC WATER LEVEL.. <u>22</u> ..ft.												
	WELL WAS USED AS:												
	<table border="0"> <tr> <td>1 Domestic</td> <td>5 Public Water Supply</td> <td>9 Dewatering</td> </tr> <tr> <td>2 Irrigation</td> <td>6 Oil Field Water Supply</td> <td>10 Monitoring Well</td> </tr> <tr> <td>3 Feedlot</td> <td>7 Lawn and Garden Only</td> <td>11 Injection Well</td> </tr> <tr> <td>4 Industrial</td> <td>8 Air Conditioning</td> <td>12 Other.....</td> </tr> </table>	1 Domestic	5 Public Water Supply	9 Dewatering	2 Irrigation	6 Oil Field Water Supply	10 Monitoring Well	3 Feedlot	7 Lawn and Garden Only	11 Injection Well	4 Industrial	8 Air Conditioning	12 Other.....
1 Domestic	5 Public Water Supply	9 Dewatering											
2 Irrigation	6 Oil Field Water Supply	10 Monitoring Well											
3 Feedlot	7 Lawn and Garden Only	11 Injection Well											
4 Industrial	8 Air Conditioning	12 Other.....											
	Was a chemical/bacteriological sample submitted to Department? Yes....No. <u>X</u>												
	If yes, mo/day/yr sample was submitted.....												
	Water Well Disinfected: Yes..... No. <u>X</u> ..												


5	TYPE OF BLANK CASING USED:										
	<table border="0"> <tr> <td>1 Steel</td> <td>3 RMP (SR)</td> <td>5 Wrought</td> <td>7 Fiberglass</td> <td>9 Other (specify below)</td> </tr> <tr> <td><u>2 PVC</u></td> <td>4 ABS</td> <td>6 Asbestos-Cement</td> <td>8 Concrete Tile</td> <td></td> </tr> </table>	1 Steel	3 RMP (SR)	5 Wrought	7 Fiberglass	9 Other (specify below)	<u>2 PVC</u>	4 ABS	6 Asbestos-Cement	8 Concrete Tile	
1 Steel	3 RMP (SR)	5 Wrought	7 Fiberglass	9 Other (specify below)							
<u>2 PVC</u>	4 ABS	6 Asbestos-Cement	8 Concrete Tile								
	Blank casing diameter... <u>1</u> ..in. Was casing pulled? Yes <u>X</u> ... No..... If yes, how much... <u>6'</u>										
	Casing height above or below land surface... <u>FLUSH</u> ..in.										

6	GROUT PLUG MATERIAL: 1 Neat cement 2 Cement grout <u>3 Bentonite</u> 4 Other.....																				
	Grout Plug Intervals: From.....ft. to.....ft., From.....ft. to.....ft., From..... to.....ft.																				
	What is the nearest source of possible contamination:																				
	<table border="0"> <tr> <td>1 Septic tank</td> <td>6 Seepage pit</td> <td>11 Fuel storage</td> <td>16 Other (specify below)</td> </tr> <tr> <td>2 Sewer lines</td> <td>7 Pit privy</td> <td>12 Fertilizer storage</td> <td><u>JUST SITE</u></td> </tr> <tr> <td>3 Watertight sewer lines</td> <td>8 Sewage lagoon</td> <td>13 Insecticide storage</td> <td></td> </tr> <tr> <td>4 Lateral lines</td> <td>9 Feedyard</td> <td>14 Abandoned water well</td> <td></td> </tr> <tr> <td>5 Cess Pool</td> <td>10 Livestock pens</td> <td>15 Oil well/Gas well</td> <td></td> </tr> </table>	1 Septic tank	6 Seepage pit	11 Fuel storage	16 Other (specify below)	2 Sewer lines	7 Pit privy	12 Fertilizer storage	<u>JUST SITE</u>	3 Watertight sewer lines	8 Sewage lagoon	13 Insecticide storage		4 Lateral lines	9 Feedyard	14 Abandoned water well		5 Cess Pool	10 Livestock pens	15 Oil well/Gas well	
1 Septic tank	6 Seepage pit	11 Fuel storage	16 Other (specify below)																		
2 Sewer lines	7 Pit privy	12 Fertilizer storage	<u>JUST SITE</u>																		
3 Watertight sewer lines	8 Sewage lagoon	13 Insecticide storage																			
4 Lateral lines	9 Feedyard	14 Abandoned water well																			
5 Cess Pool	10 Livestock pens	15 Oil well/Gas well																			
	Direction from well? ..... How many feet? .....																				

FROM	TO	PLUGGING MATERIALS
<u>28</u>	<u>22</u>	<u>bentonite</u>
<u>06</u>	<u>0</u>	<u>CLAY + NATIVE SOIL</u>

7	CONTRACTOR'S OR LANDOWNER'S CERTIFICATION: This water well was plugged under my jurisdiction and was completed on (mo/day/year) <u>4-19-98</u> ..... and this record is true to the best of my knowledge and belief. Kansas Water Well Contractor's License No. <u>606</u> ..... This Water Well Record was completed on (mo/day/year) <u>4-14-98</u> ..... under the business name of <u>ESCC dba PSA ENVIRONMENTAL</u> by (signature) <u>[Signature]</u>
---	--

INSTRUCTIONS: Use typewriter or ball point pen. Please press firmly and print clearly. Please fill in blanks, underline or circle the correct answers. Send top three copies to Kansas Department of Health and Environment, Bureau of Water, Topeka, Kansas 66620-0001. Telephone: 913/296-3565. Send one to Water Well Owner and retain one for your records.

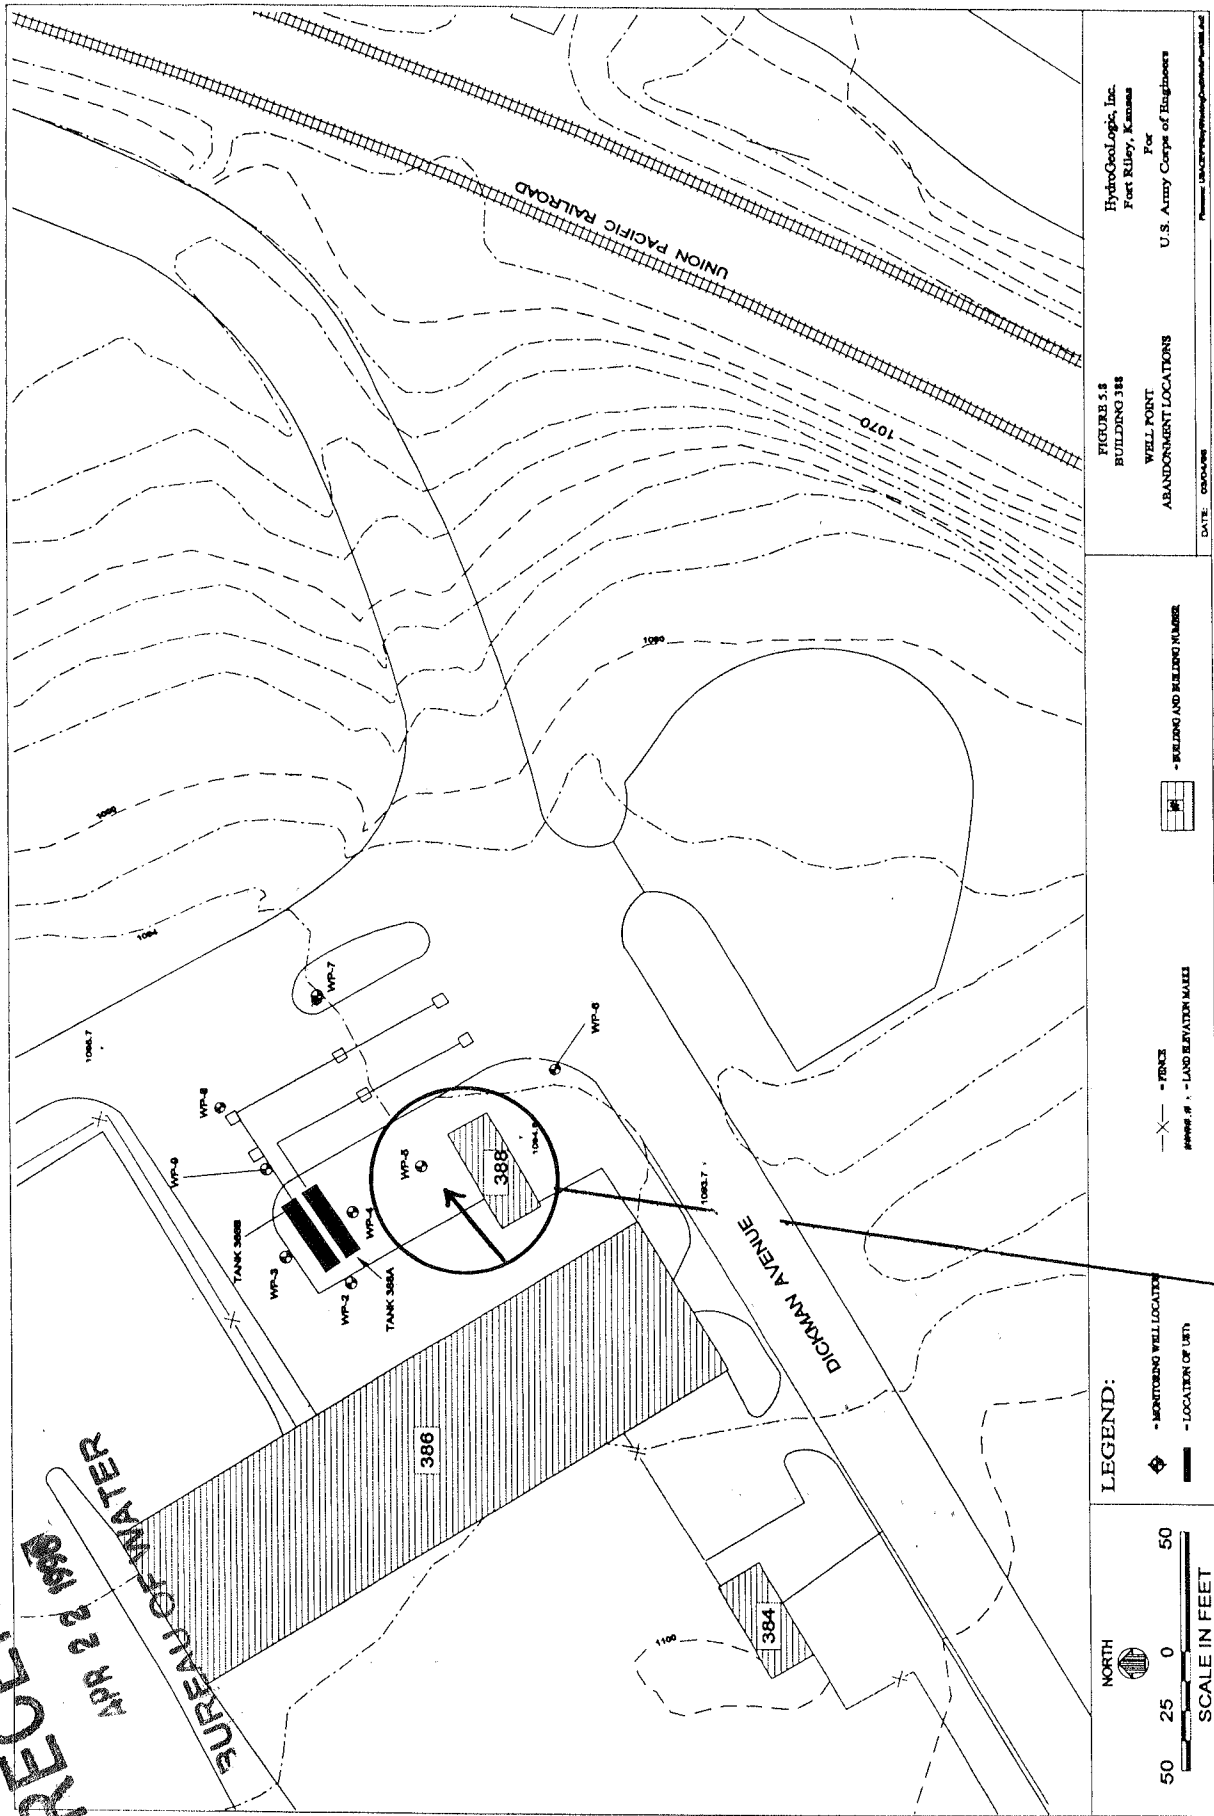

**RECEIVED**  
 APR 22 1980  
 BUREAU OF WATER

# WP-5  
 PIEZOMETER  
 BLDG 388