

1] LOCATION OF WATER WELL: County: GEARY Fraction SW 1/4 NE 1/4 Section Number 31 Township Number T 11 S Range Number R 6 (EW)

Distance and direction from nearest town or city street address of well if located within city?
FORT RILEY, KS BLDG 388 WP-6

2] WATER WELL OWNER: US ARMY CORPS OF ENGINEERS
 RR#, St. Address, Box #: 601 E 12TH ST
 City, State, ZIP Code: KANSAS CITY, MO 64106
 Board of Agriculture, Division of Water Resources
 Application Number:

3] LOCATE WELL'S LOCATION WITH AN "X" IN SECTION BOX:

N	
PLEASE SEE DWG	
NW NE	
SW SE	
S	

4] DEPTH OF COMPLETED WELL: 30 ft. ELEVATION: 1099.89
 Depth(s) Groundwater Encountered 1. 2 ft. 2. . ft. 3. . ft.
 WELL'S STATIC WATER LEVEL 27 ft. below land surface measured on mo/day/yr 3-2-95
 Pump test data: Well water was . ft. after . hours pumping . gpm
 Est. Yield . gpm: Well water was . ft. after . hours pumping . gpm
 Bore Hole Diameter . in. to . ft., and . in. to . ft.
 WELL WATER TO BE USED AS:
 1 Domestic 3 Feedlot 6 Oil field water supply 9 Dewatering 12 Other (Specify below) PIEZOMETER
 2 Irrigation 4 Industrial 7 Lawn and garden only 10 Monitoring well
 Was a chemical/bacteriological sample submitted to Department? Yes . No X; If yes, mo/day/yr sample was submitted
 Water Well Disinfected? Yes No X

5] TYPE OF CASING USED:
 1 Steel 3 RMP (SR) 6 Asbestos-Cement 9 Other (specify below)
2 PVC 4 ABS 7 Fiberglass
 Blank casing diameter 1 in. to . ft., Dia . in. to . ft., Dia . in. to . ft.
 Casing height above land surface FLUSH in., weight . lbs./ft. Wall thickness or gauge No. .
 TYPE OF SCREEN OR PERFORATION MATERIAL:
 1 Steel 3 Stainless steel 5 Fiberglass 8 RMP (SR) 11 Other (specify) . ft.
 2 Brass 4 Galvanized steel 6 Concrete tile 9 ABS 12 None used (open hole)
 SCREEN OR PERFORATION OPENINGS ARE:
 1 Continuous slot 3 Mill slot .01 6 Wire wrapped 9 Drilled holes
 2 Louvered shutter 4 Key punched 7 Torch cut 28 10 Other (specify) . ft.
 SCREEN-PERFORATED INTERVALS: From 31 ft. to 28 ft., From . ft. to . ft.
 GRAVEL PACK INTERVALS: From . ft. to . ft., From . ft. to . ft.


6] GROUT MATERIAL: 1 Neat cement 2 Cement grout 3 Bentonite 4 Other . ft. to . ft.
 Grout Intervals: From . ft. to . ft., From . ft. to . ft., From . ft. to . ft.
 What is the nearest source of possible contamination:
 1 Septic tank 4 Lateral lines 7 Pit privy 10 Livestock pens 14 Abandoned water well
 2 Sewer lines 5 Cess pool 8 Sewage lagoon 11 Fuel storage 15 Oil well/Gas well
 3 Watertight sewer lines 6 Seepage pit 9 Feedyard 12 Fertilizer storage 16 Other (specify below) UST SITE
 13 Insecticide storage

Direction from well? How many feet?

FROM	TO	LITHOLOGIC LOG	FROM	TO	PLUGGING INTERVALS
<u>0</u>	<u>31</u>	<u>DIRECT PUSH INSTALLED</u> <u>NO CUTTINGS</u>			

7] CONTRACTOR'S OR LANDOWNER'S CERTIFICATION: This water well was (1) constructed, (2) reconstructed, or (3) plugged under my jurisdiction and was completed on (mo/day/year) 3-1-95 and this record is true to the best of my knowledge and belief. Kansas Water Well Contractor's License No. 606 This Water Well Record was completed on (mo/day/yr) 4-14-98 under the business name of ESCC d/b/a PSA ENV. by (signature) [Signature]

INSTRUCTIONS: Use typewriter or ball point pen. PLEASE PRESS FIRMLY and PRINT clearly. Please fill in blanks, underline or circle the correct answers. Send top three copies to Kansas Department of Health and Environment, Bureau of Water, Topeka, Kansas 66620-0001. Telephone: 913-296-5545. Send one to WATER WELL OWNER and retain one for your records.

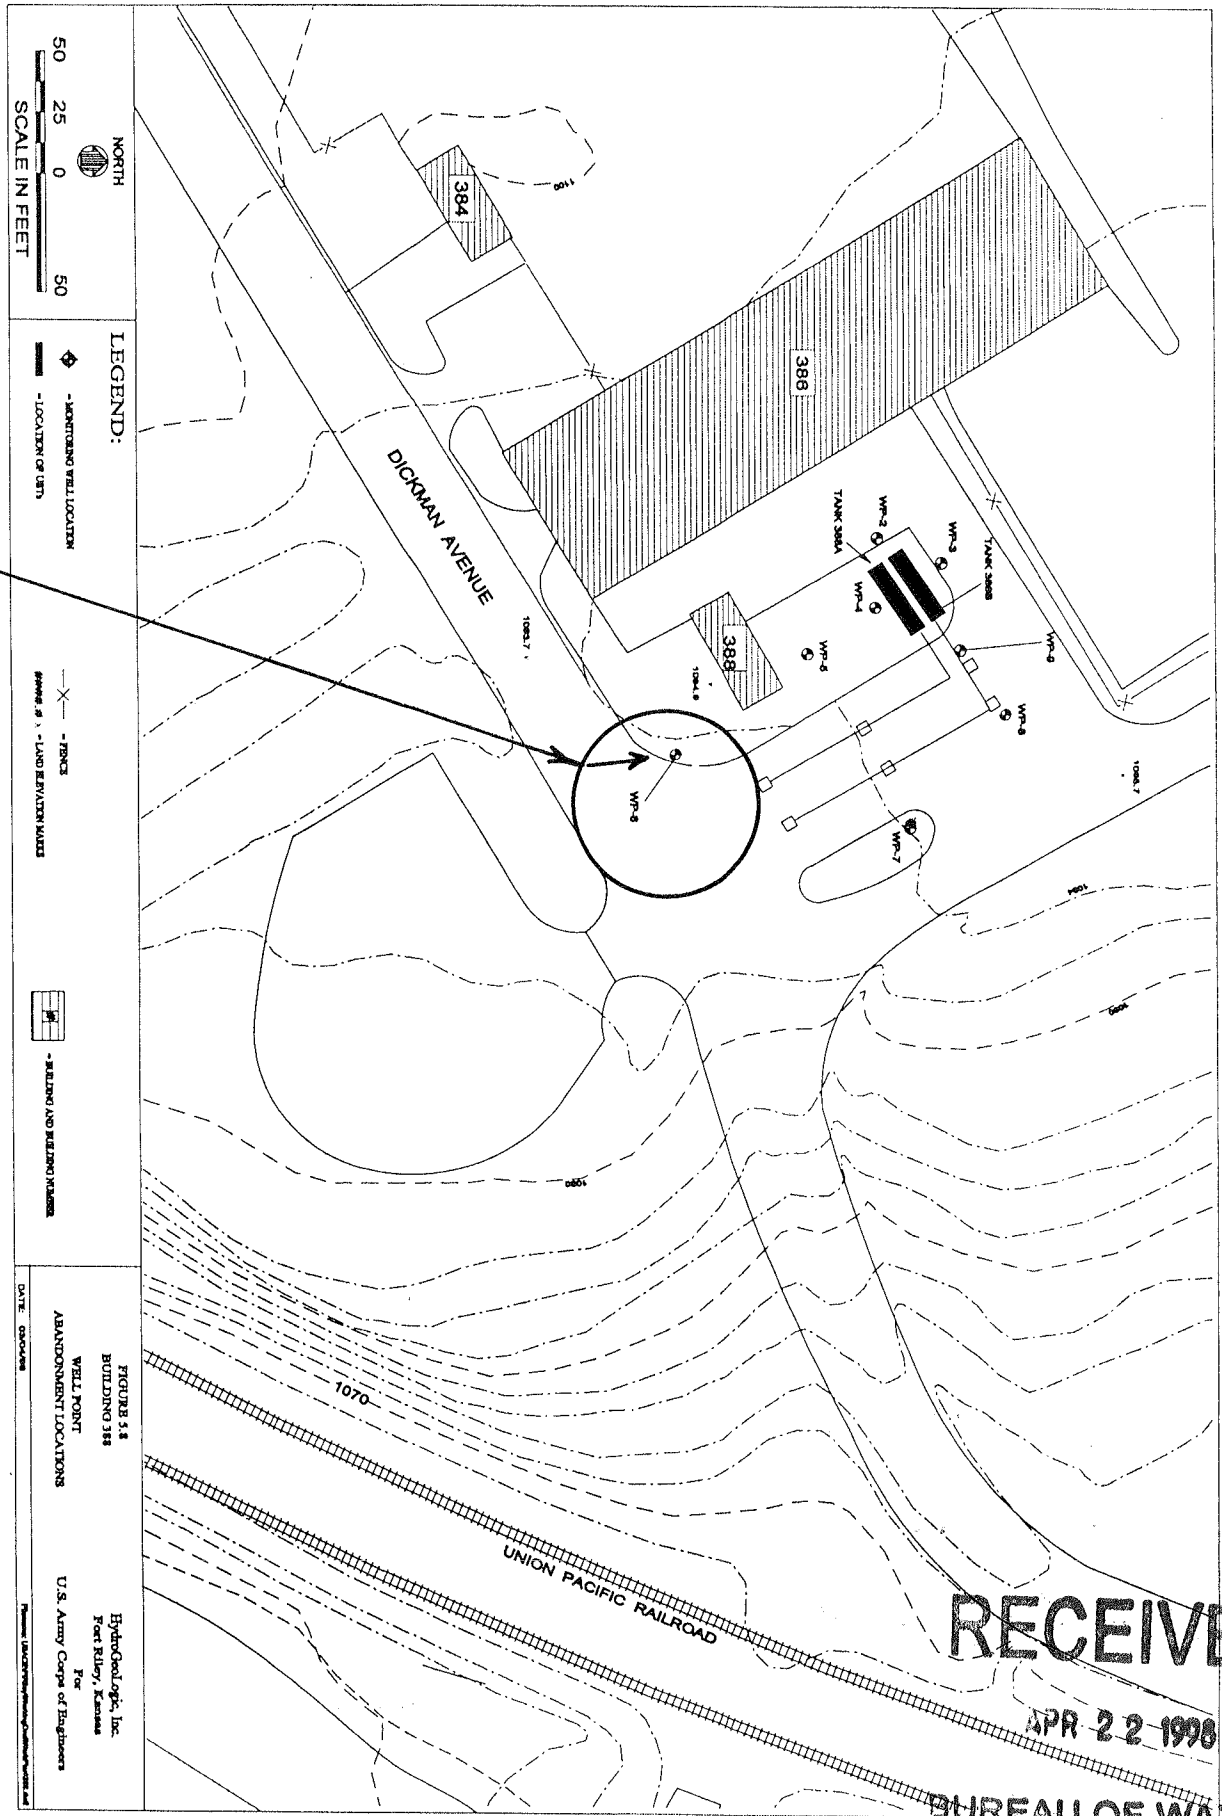

PIEZOMETER # WP-6
BLDG 388

RECEIVED

APR 22 1998

BUREAU OF WATER

FIGURE 5.8
BUILDING 388
WELL POINT
ABANDONMENT LOCATIONS

HydroGeologic, Inc.
Fort Riley, Kansas
for
U.S. Army Corps of Engineers