
				WELL RECORD	Form WWC-5	KSA 82a	-1212		
	TION OF WAT		Fraction		Engaran.	tion Number	Township	ŧ	Range Number
	and direction		SCO 1/4 I	1/4 Iress of well if located	1/4 ≤ d within city?	. 1		S S	LR 6 EN
Distance	and direction	V K C	COMP First	STON FO	MMETA	RING	1044	INAP.	-6
a war		MED INCA	OWY COL	IPS OF BY	V. IIIEE	N C			<u> </u>
			EIZI	ゴミナー	SINGE	· U	Board of	f Agriculture	Division of Water Resources
City Sta	te, ZIP Code	** : GO!	- MO	64196				ion Number:	ANDOLO OF ANGRE LIESURICES
	·····				1310	# ELEVA:		2014	
AN "X	" IN SECTIO	N BOX:	Depth Or CO	ater Encountered 1	22.1.0.	. II. ELEVA	TION: p.yw	«سرري»	
ego.	promountaines co		Depth(s) Groundwa	VATER LEVEL	. 9	alow land eur	face measured	on mo/day/yr	3-5-95
1	LAME	SE		****	•				mping gpm
	NW	NE	·						mping gpm
e)	SEC								. to
Mije M		and a second sec	WELL WATER TO	e.	5 Public wate		8 Air conditioni		
p.m.	Day Ca		1 Domestic		6 Oil field wa		9 Dewatering	A STATE OF THE PARTY OF THE PAR	Other (Specify below)
	SW	SE	2 Irrigation					ell D.	20merel
	bil ix	her II	•	cteriological sample s	submitted to De	epartment? Ye	esNo	X; If yes	mo/day/yr sample was sub-
I	AND THE PERSON NAMED IN COLUMN PARTY OF THE PERSON NAMED IN COLUMN	NAMES OF THE PROPERTY OF THE P	mitted				ter Well Disinfe	-	No X
5 TYPE	OF BLANK	CASING USED:		5 Wrought iron	8 Concre	te tile	CASING .	IOINTS: Glue	d Clamped
1 5	Steel	3 RMP (SR	1)	6 Asbestos-Cement	9 Other	(specify below	v)	Weld	ed
(2 F	PVC >	4 ABS	^~o ****9 ∡	7 Fiberglass				Thre	aded. FUSH
) ft., Dia					
				n., weight					
TYPE O	F SCREEN O	R PERFORATION	MATER!AL:		7 PV	9)	10 A	Asbestos-ceme	ent
1 5	Steel	3 Stainless	steel	5 Fiberglass	8 FIN	P (SR)	11 C	Other (specify)	
2 8	Brass	4 Galvanize	ed steel	6 Concrete tile	9 AB	S	12 N	ione used (or	en hole)
SCREEN	OR PERFO	RATION OPENING			ed wrapped		8 Saw cut		11 None (open hole)
1 (Continuous sk		10.0/ Caple 1) 6 Wire	wrapped		9 Drilled hole	es	
2 1	ouvered shut	ter 4 Ke	y punched	7 Torch					
SCREEN	I-PERFORAT	ED INTERVALS:	From. A.						oft.
			·						- A
			147	ft. to					
	GRAVEL PA	CK INTERVALS:	From	ft. to		ft., Fro	m	ft. [.]	:oft.
el ceo			From	ft. to ft. to	passance 15200111200	ft., Froi	m	ft ft	o
COLUMN TO SERVICE SERV	JT MATERIAL	.: 1 Neat ce	From From ement 2	ft. to ft. to Cement grout	3 Bento	ft., Froi	m	ft. ·	o
Grout In	JT MATERIAL tervals: Fro	.: 1 Neat co	From 2 ement 2 ft. to	ft. to ft. to Cement grout	3 Bento	ft., From	m Other ft., From	ft. ·	60
Grout In	JT MATERIAL tervals: Fro the nearest so	.: 1 Neat com	From 2 ement 2 ft. to	ft. to ft. to Cement grout ft., From	3 Bento	nite 4 10 Lives	m	ft.	to ft. to ft. to ft. to ft. to ft.
Grout In What is	JT MATERIAL tervals: Fro the nearest so Septic tank	.: 1 Neat comm	From	ft. to ft. to Cement grout ft., From	3 Bento	ft., From the ft	m Other ft., From tock pens storage	ft.	to ft. to ft. to ft. to ft. bandoned water well bil well/Gas well
Grout In What is 1 5	JT MATERIAL lervals: Fro the nearest so Septic tank Sewer lines	.: 1 Neat comm	From	ft. to ft. to Cement grout ft., From 7 Pit privy 8 Sewage lage	3 Bento	ft., From the ft	m	ft.	to ft. to ft. to ft. to ft. bandoned water well bil well/Gas well
Grout In What is 1 5 2 5 3 1	JT MATERIAL tervals: Fro the nearest so Septic tank Sewer lines Natertight sev	.: 1 Neat comm	From	ft. to ft. to Cement grout ft., From	3 Bento	ft., From tt., F	m	ft.	to ft. to ft. to ft. to ft. to ft.
Grout In What is 1 5 2 5 3 1 Direction	JT MATERIAL dervals: Fro the nearest so Geptic tank Gewer lines Watertight sev from well?	.: 1 Neat com	From	ft. to ft. to ft. to Cement grout ft., From Pit privy Sewage lag Feedyard	3 Bento ft.	ft., From the ft	m	ft.	ft. to ft. to ft. the
Grout In What is 1 5 2 5 3 V Direction	JT MATERIAL tervals: Fro the nearest so Septic tank Sewer lines Watertight sev	.: 1 Neat com	From	ft. to ft. to ft. to Cement grout ft., From Pit privy Sewage lag Feedyard	3 Bento ft.	ft., From tt., F	m	14 A 15 C 16 C POWW	ft. to ft. to ft. the
Grout In What is 1 5 2 5 3 1 Direction FROM	JT MATERIAL Bervals: Fro the nearest so Septic tank Sewer lines Watertight sev of from well? TO D D D D D D D D D D D D D D D D D D	ii 1 Neat com	From From ement 2 ft. to contamination: al lines pool age pit LITHOLOGIC L	ft. to ft. to Cement grout ft., From Pit privy Sewage lag Feedyard OG MSTDC	3 Bento ft.	nite 4 to	m	ft. ft. 14 A 15 C (16)C PLUGGING	o
Grout In What is 1 5 2 9 3 V Direction FROM O	JT MATERIAL dervals: Fro the nearest so Septic tank Sewer lines Vatertight sev from well? TO TO TRACTOR'S ad on (mo/day)	DIRECTOR OR LANDOWNER	From. From ement 2 ft. to contamination: al lines pool age pit LITHOLOGIC L Push Contamination: Contam	This water well w	3 Bento ft.	tt., Froi ft., F	onstructed, or (3 ord is true to the	ft. ft. 14 A 15 C (16)C PLUGGING	ft. to ft. to ft. the
Grout In What is 1 S 2 S 3 N Direction FROM O 7 CON complete Water W	JT MATERIAL dervals: Fro the nearest so Septic tank Sewer lines Vatertight sev from well? TO J310 TRACTOR'S ad on (mo/day Vell Contractor	DIRECT OR LANDOWNER Rivyear) 3 - 4- Cis License No. 6	From. From ement 2 ft. to contamination: al lines pool age pit LITHOLOGIC LITHOLO	This water well w This Water W	3 Bento ft.	tt., Frointe, 4 to	other Other ft., From tock pens storage izer storage itcide storage ny feet? onstructed, or (3 ord is true to the on (mo/day/yr)	ft. ft. 14 A 15 C (16)C PLUGGING	o
Grout In What is 1 S 2 S 3 N Direction FROM O Complete Water W under th	TRACTOR'S ed on (mo/day/ell Contractor e business na	DIRECTOR LANDOWNER Consumer of S C C C C C C C C C C C C C C C C C C	From From ement 2 ft. to contamination: al lines pool age pit LITHOLOGIC LITHOLO	This Water Well w	3 Bento ft.	tt., Frointe 4 to	other Other ft., From tock pens storage izer storage itcide storage ny feet? onstructed, or (3 ord is true to the on (mo/day/yr) iture)	ft.	o

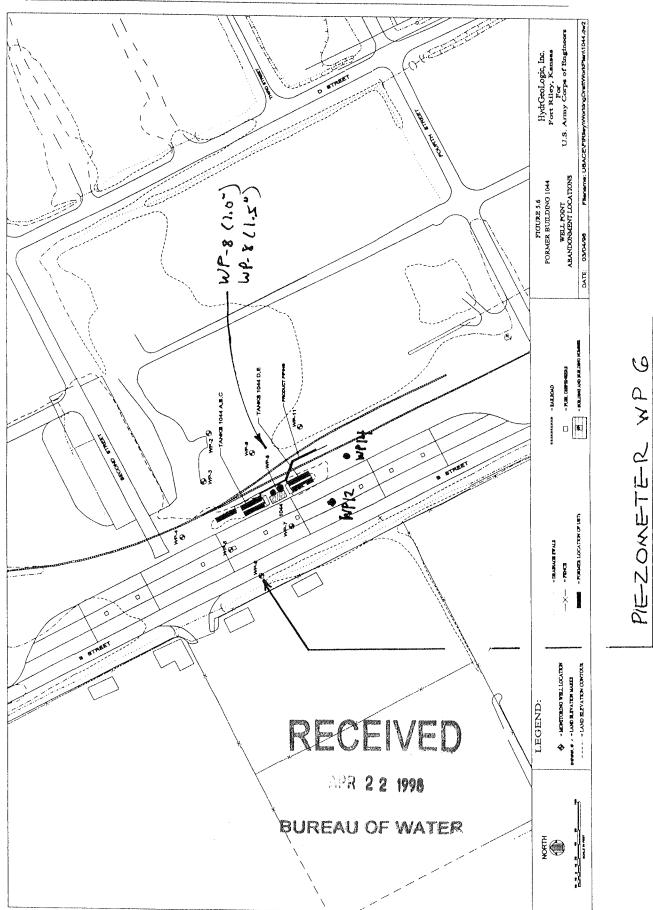

U.S. Army Corps of Engineers—Kansas City District