
1 LOCATIO	N OF WATER	WELL:	Fraction		Section	on Number	Township	Number	Rang	e Number
County: GEANY			SW14NET14	1/4	3	1	11	2	6	()
Distance and direction from nearest town or city street address of well if located within city? FORT RIGY, KS. SAMP FUNSTON FORMEN BLDG 1637 WP-6										
2 WATER WELL OWNER: US ARMY CORPS OF ENGINEERS RR#, St. Address, Box #: City, State, ZIP Code: LC MO 64106 Application Number:										
MARK WELL'S LOCATION WITH AN "X" IN SECTION BOX: N WELL WAS USED AS: 1 Domestic 5 Public Water Supply 9 Dewatering 2 Irrigation 6 Oil Field Water Supply 10 Monitoring Well 3 Feedlot 7 Lawn and Garden Only 11 Injection Well 4 Industrial 8 Air Conditioning 12 Other. N Was a chemical/bacteriological sample submitted to Department? YesNoX If yes, mo/day/yr sample was submitted										
Blank casing diameterin. Was casing pulled? YesNoIf yes, how much										
3 Watertight sewer lines 8 Sewage lagoon 13 Insecticide storage FORMON UST 4 Lateral lines 9 Feedyard 14 Abandoned water well 5 Cess Pool 10 Livestock pens 15 Oil well/Gas well 5 ITC Direction from well? How many feet?										ST
FROM TO PLUGGING MATERIALS						CREPPIORIE CROUT PUMP				
25,8 4	4 O		hita sci - Nativa	()	-		M TN			1
CONTRACTOR'S OR LANDOWNER'S CERTIFICATION: This water well was plugged under my jurisdiction and was completed on (mo/day/year)										
INSTRUCTIONS: Use typewriter or ball point pen. <u>Please press firmly</u> and <u>print</u> clearly. Please fill in blanks, underline or circle the correct answers. Send top three copies to Kansas Department of Health and Environment, Bureau of Water, Topeka, Kansas 66620-0001. Telephone: 913/296-3565. Send one to Water Well Owner and retain one for your records.										

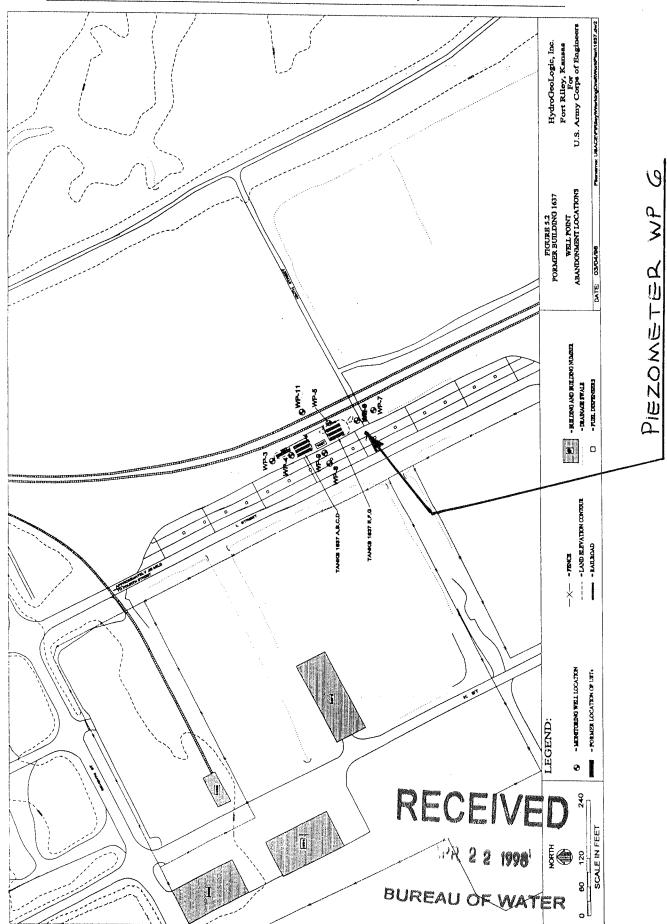

FORMER BLOG 1637

U.S. Army Corps of Engineers—Kansas City District