
1.1		400 (000 grob, ), & 4 mars - 4		ER WELL RECORD	Form WWC-5	KSA 8			
and the same of th	ION OF WA	and the second s	Fraction	A Deserve	******	tion Numbe	4 %	ı	Range Number
	MER		ISUD V		1/4 5		<u> </u>	S	P 6 (E/W
				address of well if located		0 : 6		7 . 10	7
		<u>igy,KS</u>	CHMY	FUNSTON F	Sumall.	154,	19165	L W F	'~ (O
2 WATE	r well on	NER: US	ARMY C	LORPS OF GI	y Gimbe	RS	~v		
RR#, St.	Address, Bo	x#: 6€	) I E 123	They S years			Board o	f Agriculture, D	ivision of Water Resources
	e, ZIP Code	: 14	C, MO.	64196				ion Number:	
3 LOCAT	E WELL'S L	OCATION WITH	4 DEPTH OF	COMPLETED WELL	25. K	. ft FIF\			
AN "X"	IN SECTIO	N BOX:	Denth(s) Group	dwater Encountered 1	240	, 11. to both \	2		
l. r	[ 	1	WELL'S STATE	CWATED LEVEL 2 1	7		urface meceured	on moldaylar	3-6-95
	PLS	<b>९</b> हर्द	li .						
	NW	NE	ľ	•				•	nping , gpm
	AITAC	ME'O							nping gpm
N E	17.	F	Bore Hole Diam	neterin. to .	· * 3 ! 0				to
₹ "	OWE		WELL WATER	TO BE USED AS:	5 Public water	r supply	8 Air condition	C. C	njection well
	SW	- SE -	1 Domestic		6 Oil field wat			(12)	Other (Specify below)
	1		2 Irrigation	4 Industrial	7 Lawn and g	arden only	10 Monitoring v	vell	zongter
	i		Was a chemical	/bacteriological sample s	ubmitted to De	partment?	YesNo.	; If yes,	mo/day/yr sample was sub-
Van Bas	THE CONTRACTOR OF THE CONTRACT	terment and the second	mitted			٧	Vater Well Disinfe	cted? Yes	No 🐰
5 TYPE	OF BLANK (	CASING USED:		5 Wrought iron	8 Concre	te tile	CASING .	JOINTS: Glued	Clamped
1 St		3 RMP (S	iR)	6 Asbestos-Cement		specify bel			d
2 P\	COUNTY OF THE PARTY OF THE PART	4 ABS	,	7 Fiberglass					ded FLUSH
Street managed and state	Merry		in to	•					n. to ft.
				r.m., weignt	-4	- make			
		R PERFORATIO			( 7 PV(	MANUFACTURE OF THE PARTY OF THE		Asbestos-cemer	
1 St		3 Stainles		5 Fiberglass		P (SR)			
2 Br		4 Galvania		6 Concrete tile	9 ABS	3		None used (ope	•
SCREEN	OR PERFO	RATION OPENIN	MATERIAL PROPERTY CONTRACTOR CONT		d wrapped		8 Saw cut		11 None (open hole)
1 Co	ontinuous slo	ot Č3 M	Aill slot So, C	010 6 Wire v	vrapped		9 Drilled hole	es	
2 Lo	ouvered shut	ter 4 K	(ey punched	7 Torch	cut &		10 Other (spe	cify)	
SCREEN-	PERFORATI	ED INTERVALS:	From4.5	🦫 🖔 ft. to	2. < 8	ft., F	rom	ft. to	)
			From	ft. to		ft., F	rom	ft. to	)
,	GRAVEL PA	CK INTERVALS:	vi vi						)
(	GRAVEL PA	CK INTERVALS:	vi vi			ft., F	rom	ft. to	)
	GRAVEL PA  T MATERIAL		: From.	ft. to	The state of the s	ft., F	rom	ft. to	)
	T MATERIA!	.: 1 Neat	: From From cement	ft. to ft. to ft. to ft. to 2 Cement grout	3 Bento	ft., F	rom	ft. to	)
6 GROU	T MATERIA! ervals: Fro	: 1 Neat	From cement	ft. to ft. to ft. to ft. to 2 Cement grout	3 Bento		rom	ft. to	ft
6 GROU Grout Inte What is th	T MATERIAL ervals: Fro ne nearest so	.: 1 Neat m	From cement ft. to	ft. to ft. to 2 Cement grout ft., From	3 Bento	ft., F ft., F nite to	rom	ft. to	ft. to
6 GROU' Grout Inte What is th	T MATERIAL ervals: Fro ne nearest so eptic tank	.: 1 Neat m  purce of possible 4 Late	From cement  ft. to	2 Cement grout  ft., From  7 Pit privy	3 Bento	ft., F ft., F nite to 10 Liv	rom	ft. to ft. to	ft
6 GROU Grout Inte What is th 1 Se 2 Se	T MATERIAL ervals: Fro ne nearest so eptic tank ewer lines	.: 1 Neat m  Durce of possible 4 Late 5 Cess	From cement ft. to	ft. to ft. to  2 Cement grout ft., From 7 Pit privy 8 Sewage lago	3 Bento	ft., F ft., F nite to	rom	ft. to ft. to ft. to ft. to	ft
6 GROU Grout Inte What is th 1 Se 2 Se 3 W	T MATERIAL ervals: Fro ne nearest so eptic tank ewer lines fatertight sew	.: 1 Neat m  purce of possible 4 Late	From cement ft. to	2 Cement grout  ft., From  7 Pit privy	3 Bento	ft., F ft., F ft., F nite to	rom	14 Ab	ft. to ft.  ft. to ft.  ft. wandoned water well  I well/Gas well  her (specify below)
GROU' Grout Inte What is th 1 Se 2 Se 3 W Direction	T MATERIAL ervals: Fro ne nearest so eptic tank ewer lines fatertight sew from well?	.: 1 Neat m  Durce of possible 4 Late 5 Cess	From  From  cement  ft. to	ft. to ft. to  2 Cement grout ft., From 7 Pit privy 8 Sewage lago 9 Feedyard	3 Bento ft.	ft., F ft	rom	14 Ab 15 Oi 16 Ot	ft.
6 GROU Grout Inte What is th 1 Se 2 Se 3 W	T MATERIAL ervals: Fro ne nearest so eptic tank ewer lines fatertight sew	.: 1 Neat m  Durce of possible 4 Late 5 Cess	From cement ft. to	ft. to ft. to  2 Cement grout ft., From 7 Pit privy 8 Sewage lago 9 Feedyard	3 Bento	ft., F ft., F ft., F nite to	rom	14 Ab	ft.


GROUT Interval of the second o	T MATERIAL ervals: Frome nearest sceptic tank ewer lines (atertight sew from well? TO Z S, &	.: 1 Neat m purce of possible 4 Later 5 Cess ver lines 6 Seep  DIREC	From From	# TOUCS	3 Bento ft.	ft., F ft	rom	14 Ab 15 Oi 16 Ot PLUGGING IN	ft. ft.  ft. to
GROUT Interval of the second o	T MATERIAL ervals: Frome nearest sceptic tank ewer lines (atertight sew from well? TO Z S, &	.: 1 Neat m purce of possible 4 Later 5 Cess ver lines 6 Seep  DIREC	From From	# TOUCS	3 Bento ft.  FROM SS (1) Jonstructure	ft., F ft	rom	14 Ab 15 Oi 16 Ot PLUGGING IN	ft. to
GROUT Inter What is the second of the second	T MATERIAL ervals: From ne nearest so eptic tank ewer lines attertight sew from well?  Z 5, 8  RACTOR'S of on (mo/day)	.: 1 Neat m	E From From  cement .ft. to contamination: ral lines s pool page pit  LITHOLOGIC  TO PUS  THE SETTIFICATE  THE SETT	7 Pit privy 8 Sewage lago 9 Feedyard LOG  TIVES	as (1) Jonstrue	ft.



hay.

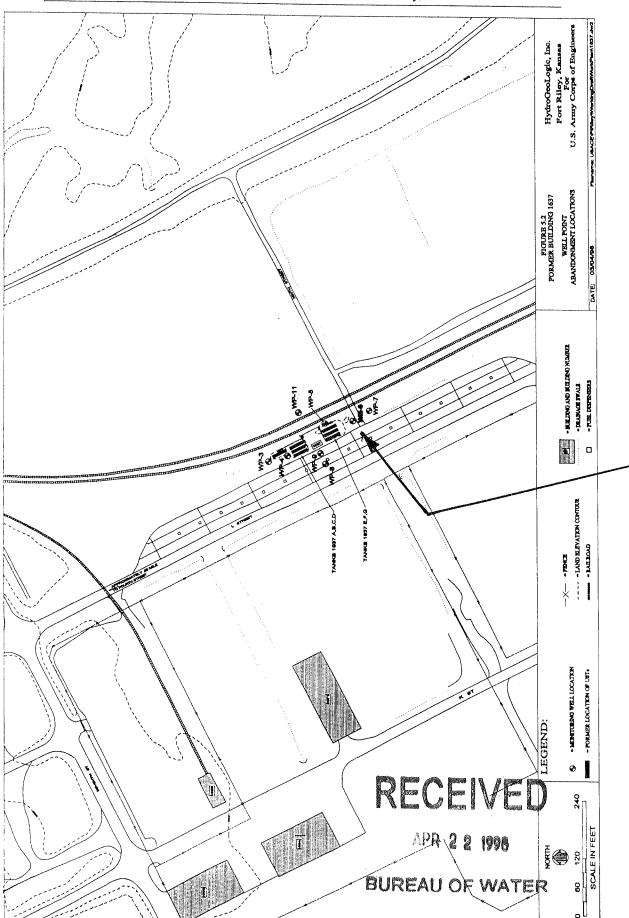

PIEZOMETER WP

FORMER BLDG 1637

U.S. Army Corps of Engineers—Kansas City District