
or simple recommendation	····			R WELL RECORD F	orm WWC-5	KSA 82	a-1212			
	ION OF WA		Fraction		Sec	tion Number	r Township I	Number	Range Nu	mber
	MARGE		1560 1/4		1/4 5		T //	<u>S</u>	I R G	(E)W
		from nearest tow	n or city street ac	dress of well if located	within city?	. (1)	g.			-
	MT 1	VICEY K	$\frac{150}{2}$	DG 38		UP-7				
and a	R WELL OV		0/ E /	POLPS OF G	n Gwei	auz.				
	Address, Bo	6.0	- 40					_	Division of Water	Resources
	e, ZIP Code		C, MO		0			n Number:		
AN "X	IN SECTIO	N BOX:	Depth(s) Ground	OMPLETED WELL. Z vater Encountered 1.5	Z.S	ft.	2	ft. 3	3	
ā	PUBAS		WELL'S STATIC WATER LEVEL 2.3 ft. below land surface measured on mo/day/yr .3 - 2 - 7 Pump test data: Well water was ft. after hours pumping Est. Yield gpm: Well water was ft. after hours pumping							
	e and the e	O I							ımping	gpm
	CCE								ımping	gpm
e w	23C/C		Bore Hole Diameter							
ž w	ATTACL	160	WELL WATER T	O BE USED AS: 5	Public water	r supply	8 Air conditionin	g 11	Injection well	
ī	SW	SE	1 Domestic	3 Feedlot 6	Oil field wa	ter supply	9 Dewatering	12	Other (Specify be	elow)
	DWG		2 Irrigation				10 Monitoring we			
		fillipotetian operation (to the comment of the construction of the	Was a chemical/b mitted	acteriological sample su	bmitted to De		YesNo \ ater Well Disinfect		i, mo/day/yr samp No	le was sub-
5 TYPE	OF BLANK	CASING USED:		5 Wrought iron	8 Concre				d Clampe	d
1 S		3 RMP (SF	₹)	6 Asbestos-Cement	9 Other	(specify belo	ow)	Weld	led	
€2 P	VC>	4 ABS	•	7 Fiberglass			,	Thre	X hahe	
Blank cas	sing diameter	· /	in. to . 28, 5.	· · · · ft., Dia · · · · · · ·	in. to		ft., Dia		in. to	ft.
Casing he	eight above l	and surface. F.C.	USA	in., weight		Ibs	./ft. Wall thickness	or gauge N	10. Sched 40	2
		R PERFORATION			< 7 PV	MATERIAL STATE OF THE STATE OF		bestos-cem		
1 S	teel	3 Stainless	steel	5 Fiberglass	The state of the s	P (SR)) <i></i>	
2 B	rass	4 Galvanize	ed steel	6 Concrete tile	9 AB			one used (o		
SCREEN	OR PERFO	RATION OPENING	GS ARE:	5 Gauzed	wrapped		8 Saw cut		11 None (open	hole)
1 C	ontinuous sk	ot 3 Mi	Il slot > 0/	6 Wire wr	apped		9 Drilled holes			
2 L	ouvered shut	ter 4 Ke	y punched	7 Torch o	On minute distant					
SCREEN	-PERFORAT	ED INTERVALS:	From. 🚧 🐧	v ft. to	15.5	ft., Fro	om	ft.	to	ft.
			and and	ft. to						
	GRAVEL PA	CK INTERVALS:	From	ft. to		ft., Fro	om	ft.	to	ft.
			From	ft. to		ft., Fro				
manuf.	T MATERIAI			2 Cement grout			Other			
Grout Inte				ft., From	ft.					
		ource of possible of		ong pour,			stock pens		Abandoned water	well
1 Septic tank 4 Lateral lines 2 Sewer lines 5 Cess pool			7 Pit privy	11 Fuel storage			15 Oil well/Gas well			
			•	8 Sewage lagoo	n		ilizer storage		Other (specify belo	ow)
		ver lines 6 Seepa	age pit	9 Feedyard			cticide storage	0.2	T.S.r.E.	
FROM	from well?	i .	LITHOLOGIC I	OG	FROM	TO How ma	any feet?	PLUGGING	INTERVALS	
	1				1110141				it that to the C	
25,5	0	DIVECT	- PUSA	INSTRICTED						
		luc c.	Pro 111 2 0	THE RESERVE AND ADDRESS OF THE PARTY OF THE						~~~
		NO CU	MIMES							
								1 A A 1 A.		
			-70							
***************************************							- VIV		e eranament erange erana e	
	·						1,000 50 10			
					······································		- A Marketine of the second of			
	~~~									
						4.4	201.7-200		AN THE REAL PROPERTY OF THE PR	
7 CONIT	DACTORIO		PO OFFICIOATI	ONL This	<u></u>	stad (O)			alam aan too to the	
COMPlete:	HACTORS	OH LANDOWNEH	-95	ON: This water well was	Constru	ciea, (2) rec	constructed, or (3)	plugged un	der my jurisdiction	n and was
COHIDIETE						and this rec	ord is true to the b	iest of my kr	owiedde and beli	er. Kansas.
Mater M.	f on (mo/day	ryear)	COC	"Plain National 184"	l Dage	a anno 1-4	Land Committee of the L	1/4-	90	
Water We	ell Contractor	's License No	606	This Water Wel	l Record wa	s completed	l on (mo/day/yr)	7-14-	98	
Water We under the	ell Contractor business na	's License No ume of 🕳 SCC	2 dy by	This Water Well PSA ENV.	l Record wa	s completed by (sign	l on (mo/day/yr) ature)	1-14	I Den	

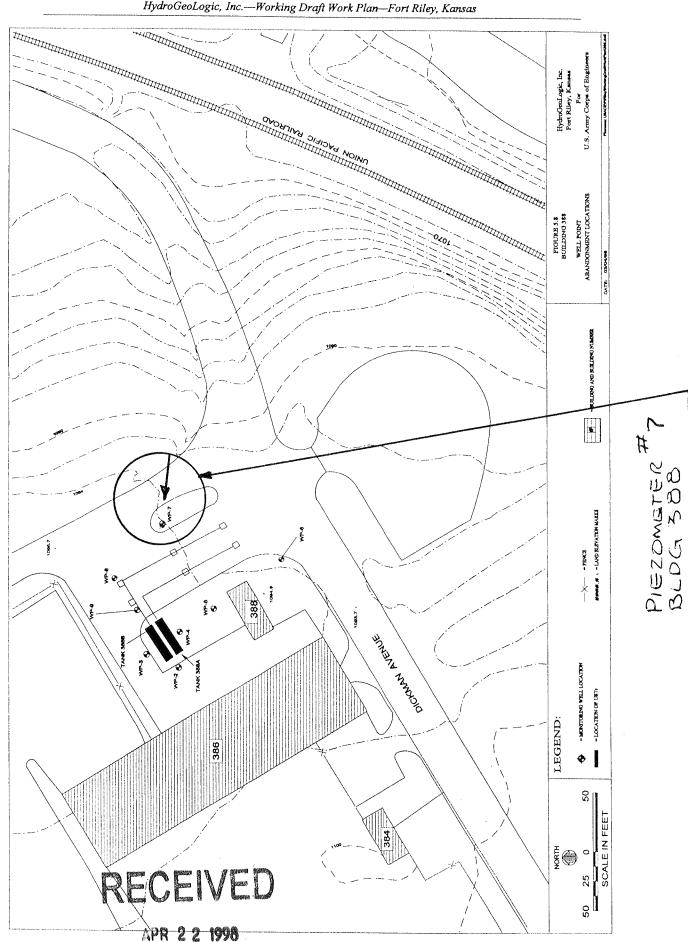

U.S. Army Corps of Engineers—Kansas City District