
			WATE	R WELL RECORD	Form WWC-5	KSA 82a	a-1212		
1 LOCAT	ION OF WAT	ER WELL:	Fraction		Sec	tion Number	Township	Number	Range Number
County: (JEAN	Y	560 14	NE 14	1/4 3	1	T /(S	R 6 EW
				ddress of well if locate			4 0	-	
	KILEY	KS. C	amp fun	ston Four	NEN CBU	06-19	944 L	1-40	
2 WATE	R WELL OW	NER: INC IA	MMY CO	UPS OF EN	SINIES C	1		- t	
	Address, Box		EIZTH	1 5 7			Board (of Adriculture 1	Division of Water Resources
	•	* : KC	, mo 6	n				tion Number:	Sivision of Water Hesources
City, State	o, ZIP Code			TIOO	210		Applica	ion Number:	
J LOCAT	E WELL'S L	OCATION WITH	4 DEPTH OF C	COMPLETED WELL.	7.7.9	. ft. ELEVA	ATION: /. 📿	6.4.80	
V14 V	IIV SECTION	4							
ī	Octo	cal	WELL'S STATIC	WATER LEVEL $: \mathcal{Q}_{+}$	ا کی ft. be	elow land su	rface measured	on mo/day/yr	3-4-98
	4 4 5	25B	Pumi	p test data: Well wat	er was	ft. a	after	hours pu	mping gpm
1	NW	- 1 1	· ·					=	mping gpm
	AMAC								. toft.
₩ ¥	4	E CONTRACTORISMONIA CONTRACTORISMONIA E					8 Air condition		
~	DWG			TO BE USED AS:	5 Public water			man Office.	Injection well
	SW	SE	1 Domestic		6 Oil field wat	er supply	9 Dewatering	9/57	Other (Specify below)
	9	0	2 Irrigation	4 Industrial	7 Lawn and g	arden only	10 Monitoring	well	ONETER
	9	0	Was a chemical/	bacteriological sample	submitted to De	partment? Y	'esNo.	; If yes	, mo/day/yr sample was sub-
T	(COND. Les above 10 a. C. S. C. S	mitted			Wa	ater Well Disinfe	cted? Yes	No X
5 TYPE	OF BLANK O	CASING USED:		5 Wrought iron	8 Concre	te tile	CASING	JOINTS: Glue	d Clamped
سے 1 S	eel	3 RMP (SF	3)	6 Asbestos-Cement	9 Other	specify belo	w)	Weld	ed
-2 P	respectation of the same of th	4 ABS	',	7 Fiberglass					aded FUSH
Contract of the contract of th	- Carlot	· · ·	in An	· ·					
									in. to ft.
_				.in., weight	Elizabanean Training Color	Nacional Contract of the Contr			· 2CH 40
TYPE OF	SCREEN O	R PERFORATION	N MATERIAL:		7 PV	2)	10	Asbestos-ceme	ent
1 S	eel	3 Stainless	steel	5 Fiberglass	8 RM	P (SR)	11	Other (specify)	
2 B	ass	4 Galvaniza	ed steel	6 Concrete tile	9 AB	S	12	None used (op	en hole)
SCREEN	OR PERFOR	RATION OPENING	GS ARE:	5 Gauz	zed wrapped		8 Saw cut		11 None (open hole)
1 C	ontinuous slo	t _3 Mi	C,Q C tols III		wrapped		9 Drilled hol	es	, ,
	ouvered shut		ey punched		h cut				
6. L.	dvered shad	.61 ** 110	y punched by A	/ 1010			To Other (abe	city)	
CODEEN	DEDECIDATI		Erom 014	ft to		64 Ere	N/0	ft f	· · · · · · · · · · · · · · · · · · ·
SCREEN	PERFORATI	ED INTERVALS:	From.	ft. to .	<i>&!</i>				:0ft.
	GRAVEL PA	ED INTERVALS: CK INTERVALS: .: 1 Neat of	From. From. From. From		3 Bento	ft., Fro ft., Fro ft., Fro	om	ft. 1	
	GRAVEL PA	ED INTERVALS: CK INTERVALS: .: 1 Neat of	From. From. From. From		3 Bento	ft., Fro ft., Fro ft., Fro	om	ft. 1	
6 GROU	GRAVEL PA T MATERIAL ervals: Fro	ED INTERVALS: CK INTERVALS: .: 1 Neat of	From.		3 Bento	ft., Fro ft., Fro ft., Fro nite 4	om	ft. 1	
6 GROU Grout Inte What is th	GRAVEL PA T MATERIAL ervals: From	ED INTERVALS: CK INTERVALS: .: 1 Neat com.	From From From cement ft. to contamination:		3 Bento	ft., Fro ft., Fro ft., Fro nite 4 to	om	ft. 1 ft. 1 ft. 1	to
6 GROU Grout Inte What is the	GRAVEL PA T MATERIAL ervals: From the nearest so eptic tank	CK INTERVALS: .: 1 Neat communication of possible 4 Laters	FromFromFromFromcontamination:		3 Bento	ft., Fro ft., Fro ft., Fro nite 4 to 10 Live	om	ft. 1 ft. 1 ft. 1 14 A 15 C	to
6 GROU Grout Inte What is th 1 S 2 S	GRAVEL PA T MATERIAL ervals: From the nearest so eptic tank ewer lines	CK INTERVALS: 1 Neat communication of possible 4 Laters 5 Cess	From. From Sement ft. to	ft. to ft.	3 Bento	ft., Fro ft., Fro ft., Fro nite 4 to 10 Live 11 Fuel 12 Ferti	om	ft. 1 ft. 1 ft. 1 14 A 15 C	ft. to ft
6 GROU Grout Inte What is the 1 S 2 S 3 W	GRAVEL PA T MATERIAL ervals: From the nearest so eptic tank ewer lines datertight sew	CK INTERVALS: .: 1 Neat communication of possible 4 Laters	From. From Sement ft. to		3 Bento	ft., From the ft	om Other Stock pens storage citicide storage	ft. 1 ft. 1 ft. 1 14 A 15 C	to
6 GROU Grout Inte What is the 1 S 2 S 3 W Direction	GRAVEL PA T MATERIAL ervals: From ne nearest so eptic tank ewer lines vatertight sew from well?	CK INTERVALS: 1 Neat communication of possible 4 Laters 5 Cess	From. From. From cement ft. to	ft. to	3 Bento ft.	ft., From the ft	om	ft. 1 ft. 1 ft. 1 14 A 15 C	ft. to ft
G GROU Grout Inte What is the 1 S 2 S 3 W Direction FROM	GRAVEL PA T MATERIAL ervals: From the nearest so eptic tank ewer lines vatertight sew from well?	CK INTERVALS: 1 Neat communication of possible 4 Laters 5 Cess	From. From Sement ft. to	ft. to	3 Bento	ft., From the ft	om Other Stock pens storage citicide storage	ft. 1 ft. 1 ft. 1 14 A 15 C	ft. to ft






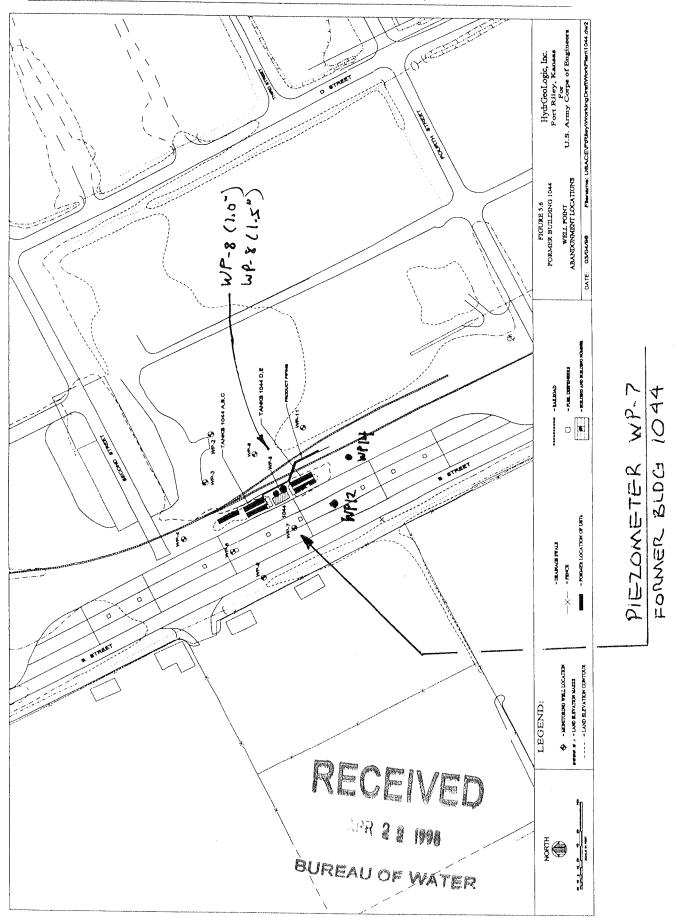

U.S. Army Corps of Engineers—Kansas City District