

1	LOCATION OF WATER WELL: County: GEARY	Fraction SW 1/4 NE 1/4 1/4	Section Number 31	Township Number 11	Range Number 6 E
---	---	--------------------------------------	-----------------------------	------------------------------	----------------------------

Distance and direction from nearest town or city street address of well if located within city?
FORT RILEY KS - CAMP FUNSTON FORMER BLDG 1245 WP-7

2 WATER WELL OWNER: **US ARMY CORPS OF ENGINEERS**
601 E. 12TH ST
 RR#, St. Address, Box #: **KC, MO. 64106**
 City, State, ZIP Code : **KC, MO. 64106**
 Board of Agriculture, Division of Water Resources
 Application Number:

3	MARK WELL'S LOCATION WITH AN "X" IN SECTION BOX: N W E S	4	DEPTH OF WELL..... 24ft. WELL'S STATIC WATER LEVEL..... 15'ft. WELL WAS USED AS: 1 Domestic 2 Irrigation 3 Feedlot 4 Industrial 5 Public Water Supply 6 Oil Field Water Supply 7 Lawn and Garden Only 8 Air Conditioning 9 Dewatering 10 Monitoring Well 11 Injection Well 12 Other..... PIEZOMETER Was a chemical/bacteriological sample submitted to Department? Yes....No X . If yes, mo/day/yr sample was submitted..... Water Well Disinfected: Yes..... No X ..
---	--	---	--

PLEASE SEE
ATTACHED DWG


5 TYPE OF BLANK CASING USED:
 1 Steel
 2 **PVC**
 3 RMP (SR)
 4 ABS
 5 Wrought
 6 Asbestos-Cement
 7 Fiberglass
 8 Concrete Tile
 9 Other (specify below)
 Blank casing diameter...**1.5**...in. Was casing pulled? Yes **X** No..... If yes, how much...**3.5**...
 Casing height above or below land surface.....in.

6 GROUT PLUG MATERIAL: 1 Neat cement 2 Cement grout **3 Bentonite** 4 Other.....
 Grout Plug Intervals: From...**2.4**...ft. to **3**...ft., From.....ft. toft., From..... toft.
 What is the nearest source of possible contamination:
 1 Septic tank 2 Sewer lines 3 Watertight sewer lines 4 Lateral lines 5 Cess Pool
 6 Seepage pit 7 Pit privy 8 Sewage lagoon 9 Feedyard 10 Livestock pens
 11 Fuel storage 12 Fertilizer storage 13 Insecticide storage 14 Abandoned water well 15 Oil well/Gas well
 16 Other (specify below) **FORMER UST SITE**
 Direction from well? How many feet?

FROM	TO	PLUGGING MATERIALS
24	3.5	bentonite
3.5	0	CLAY + NATIVE SOIL

7 CONTRACTOR'S OR LANDOWNER'S CERTIFICATION: This water well was plugged under my jurisdiction and was completed on (mo/day/year) **4-9-98** and this record is true to the best of my knowledge and belief. Kansas Water Well Contractor's License No. **696** This Water Well Record was completed on (mo/day/year) **4-14-98** under the business name of **ENV. SCI. & CON. CTL. (PSA ENV.)**
 by (signature) *[Signature]*

INSTRUCTIONS: Use typewriter or ball point pen. Please press firmly and print clearly. Please fill in blanks, underline or circle the correct answers. Send top three copies to Kansas Department of Health and Environment, Bureau of Water, Topeka, Kansas 66620-0001. Telephone: 913/296-3565. Send one to Water Well Owner and retain one for your records.

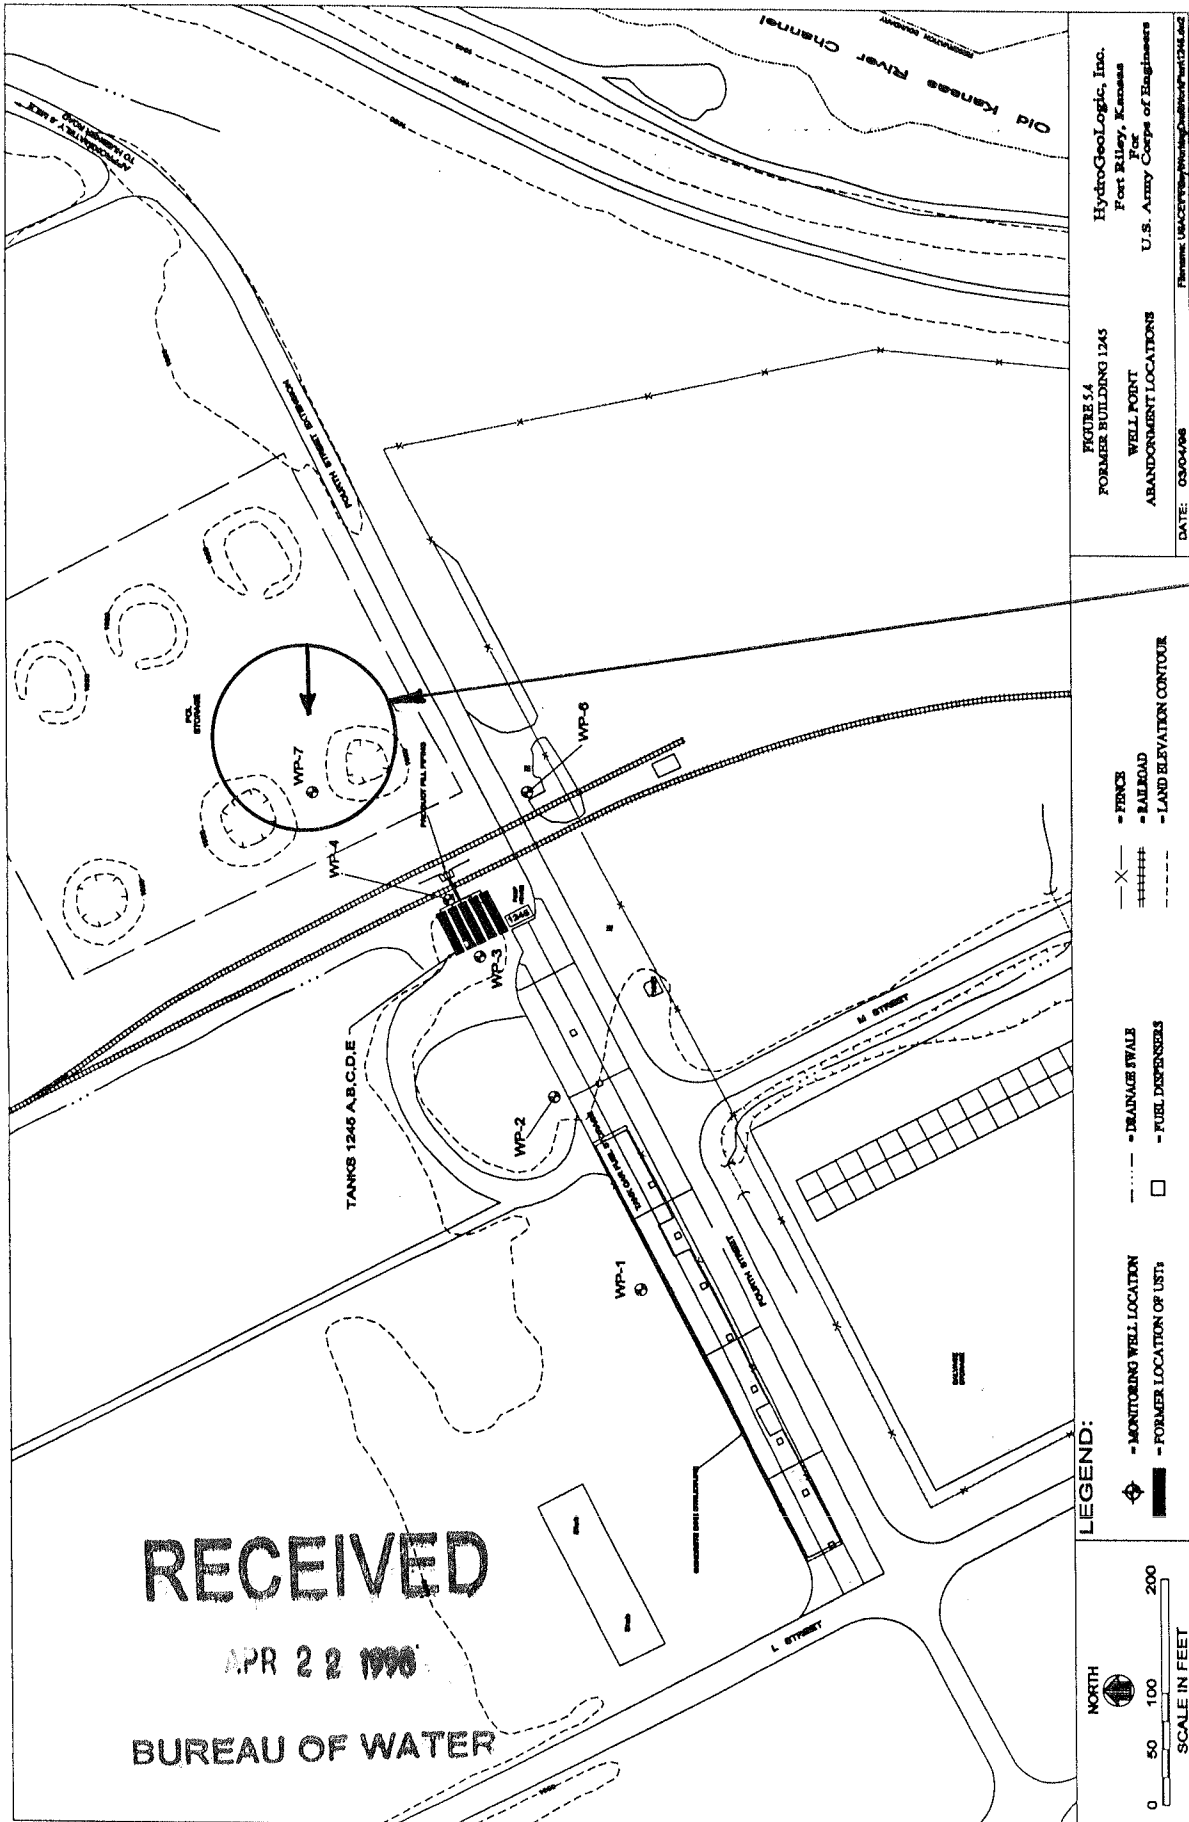

PIEZOMETER # 7
 FORMER BLDG 1245